



CITY OF
PRINCE GEORGE

City of Prince George HISTORY SHEET

PID:	032-201-320
SD/MU:	SD100778
WO:	

CIVIC ADDRESS: 1131 LEGACY RD


LEGAL DESCRIPTION: LOT 1 DISTRICT LOT 748 PLAN EPP133748

SERVICE TYPE	DIAMETER (mm)	MATERIAL	INVERT ELEV AT MAIN (m)	INVERT ELEV AT PROPERTY LINE (m)	INVERT ELEV AT SERVICE END (m)	COVER AT PROPERTY LINE (m)	DISTANCE INTO PROPERTY (m)	INSTALLATION DATE
SANITARY	150	PVC	676.34	676.65	676.75	3.31	3.00	AUG 23
WATER	200	PVC	676.70	676.98	677.03	3.06	3.00	AUG 23
STORM	250	PVC	677.09	677.44	677.50	2.79	3.00	AUG 23

ELECTRICAL / COMMUNICATIONS / GAS			
TYPE	PROVIDER	SIZE AND MATERIAL	LOCATION (UNDERGROUND/ OVERHEAD)
ELECTRICAL	BC HYDRO	75mm DB2	UNDERGROUND
COMMUNICATION	TELUS	100mm DB2	UNDERGROUND
COMMUNICATION	SHAW	50mm DB2	UNDERGROUND

INFORMATION SHEETS: L&M ENGINEERING LIMITED PROJECT NUMBER 1615-15	SURVEY DATE: AUG 23
INSTALLED BY: MGN PROJECT MANAGEMENT INC.	
COMMENTS:	

THE INFORMATION CONTAINED HEREIN IS FOR INTERNAL USE ONLY.
NOT TO BE RELIED UPON UNLESS CONFIRMED BY SITE INVESTIGATION.

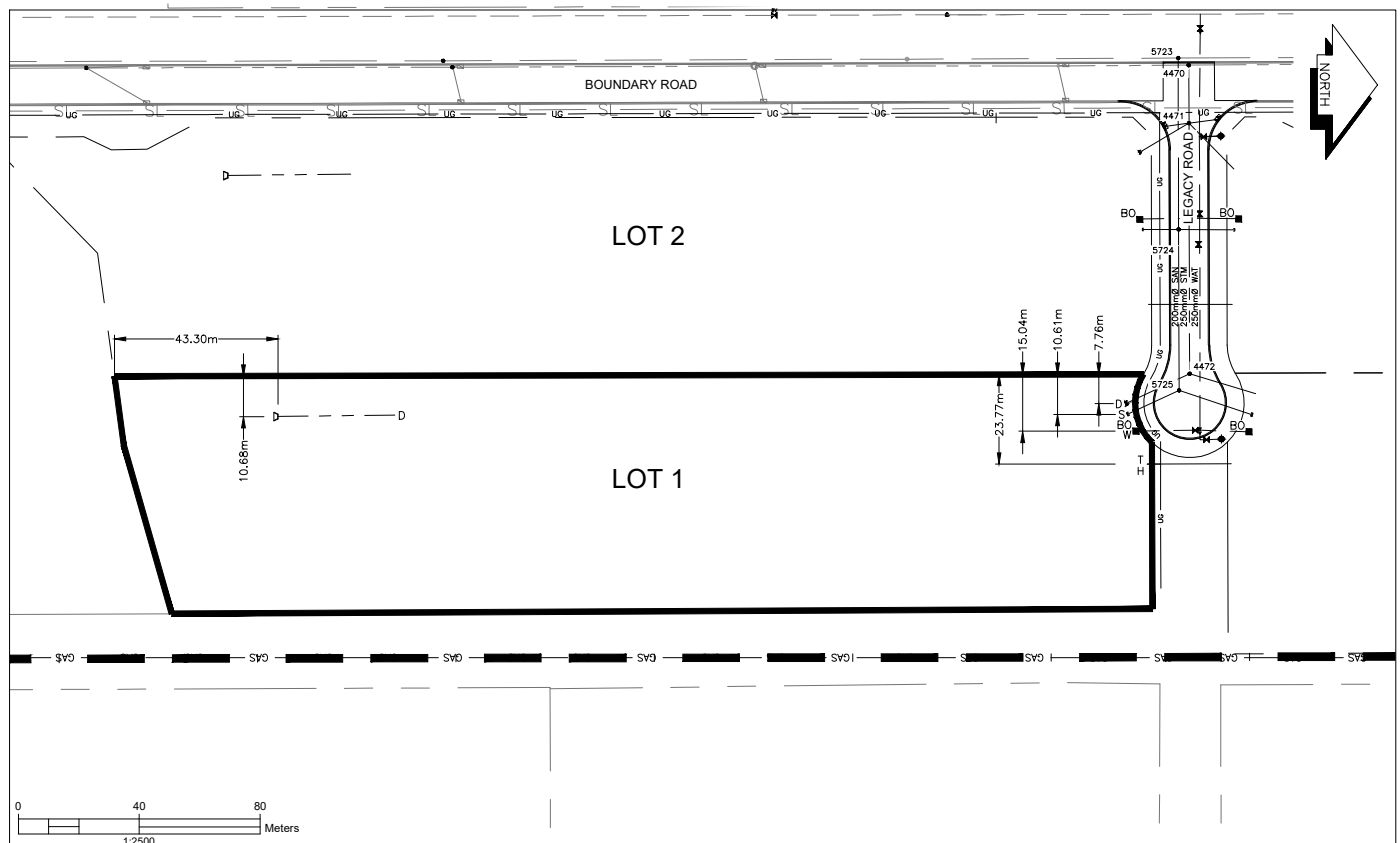

LEGEND:	BO ■ BLOW-OFF	— W — WATER SERVICE	— H — HYDRO SERVICE	— GAS — GAS
		— S — STORM SERVICE	— T — TELECOMMUNICATIONS	— UG — GAS SHALLOW UTILITIES
		— S — SANITARY SERVICE		