



City of Prince George HISTORY SHEET

CITY OF
PRINCE GEORGE

| | |
|--------|-------------|
| PID: | 032-201-338 |
| SD/MU: | SD100778 |
| WO: | |

CIVIC ADDRESS: 1055 LEGACY RD


LEGAL DESCRIPTION: LOT 2 DISTRICT LOT 748 PLAN EPP133748

| SERVICE TYPE | DIAMETER (mm) | MATERIAL | INVERT ELEV AT MAIN (m) | INVERT ELEV AT PROPERTY LINE (m) | INVERT ELEV AT SERVICE END (m) | COVER AT PROPERTY LINE (m) | DISTANCE INTO PROPERTY (m) | INSTALLATION DATE |
|--------------|---------------|----------|-------------------------|----------------------------------|--------------------------------|----------------------------|----------------------------|-------------------|
| SANITARY | 150 | PVC | 675.39 | 675.42 | 675.63 | 2.72 | 3.00 | AUG 23 |
| WATER | 200 | PVC | 674.68 | 674.62 | 674.61 | 3.46 | 3.00 | AUG 23 |
| STORM | 250 | PVC | 675.04 | 675.18 | 675.23 | 2.11 | 3.00 | AUG 23 |

| ELECTRICAL / COMMUNICATIONS / GAS | | | |
|-----------------------------------|----------|-------------------|-----------------------------------|
| TYPE | PROVIDER | SIZE AND MATERIAL | LOCATION (UNDERGROUND/ OVERHEAD) |
| ELECTRICAL | BC HYDRO | 75mm DB2 | UNDERGROUND |
| COMMUNICATION | TELUS | 100mm DB2 | UNDERGROUND |
| COMMUNICATION | SHAW | 50mm DB2 | UNDERGROUND |

| | |
|--|---------------------|
| INFORMATION SHEETS: L&M ENGINEERING LIMITED PROJECT NUMBER 1615-15 | SURVEY DATE: AUG 23 |
| INSTALLED BY: MGN PROJECT MANAGEMENT INC. | |
| COMMENTS: | |

THE INFORMATION CONTAINED HEREIN IS FOR INTERNAL USE ONLY.
NOT TO BE RELIED UPON UNLESS CONFIRMED BY SITE INVESTIGATION.

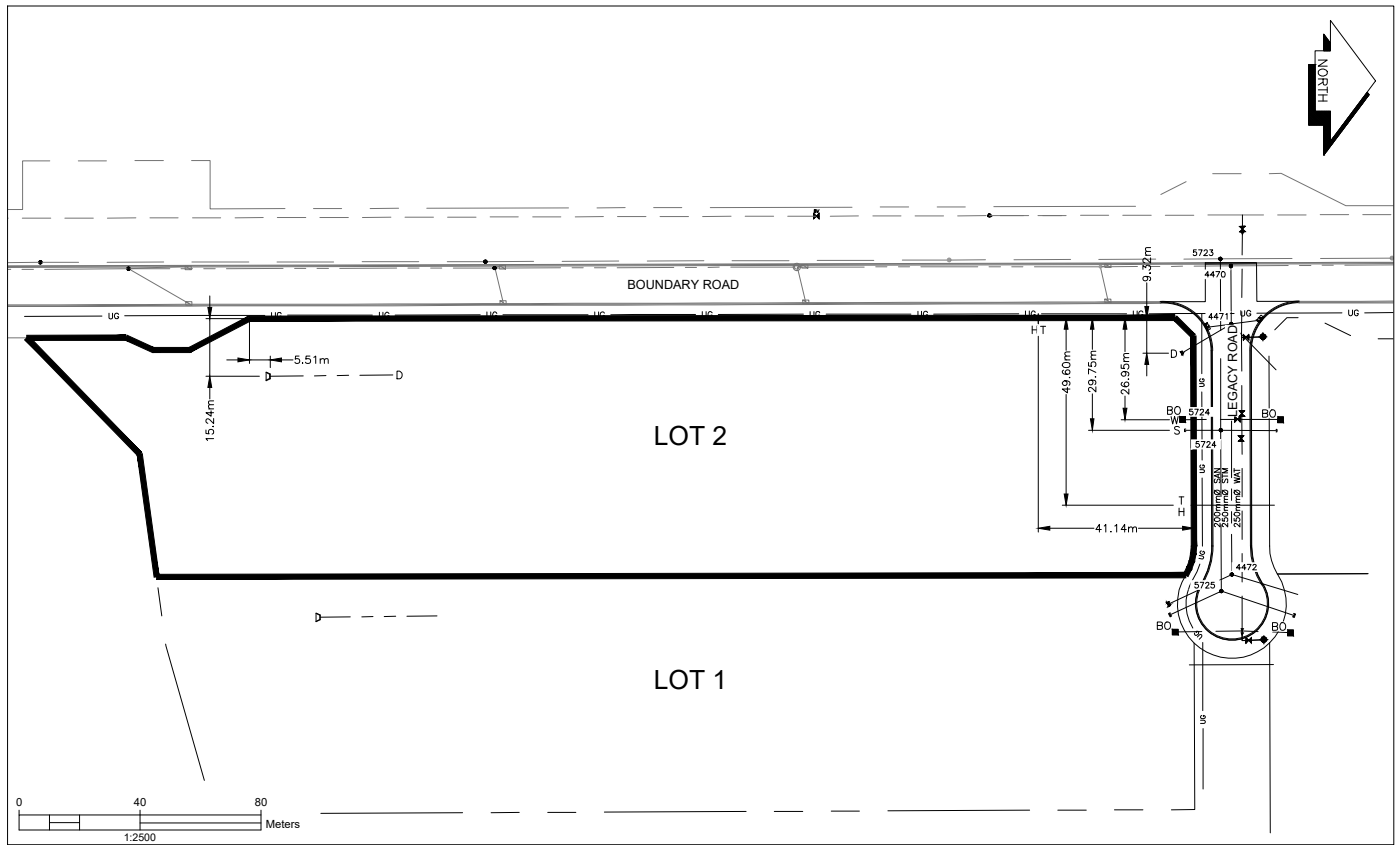

| | | | | |
|----------------|---------------|--|---|-------------------------------------|
| LEGEND: | BO ■ BLOW-OFF | ——— W WATER SERVICE - - - - S STORM SERVICE S SANITARY SERVICE | — ⊥ HYDRO SERVICE — ⊥ TELECOMMUNICATIONS | — — — GAS — UG SHALLOW UTILITIES |
|----------------|---------------|--|---|-------------------------------------|