

City of Prince George HISTORY SHEET

Joseph G...

SHEET NUMBER **8450** Roll Number

Legal: LOT'S ~~30~~⁶ BLOCK D.L. 2013 PLAN ~~2317~~^{EPP119189}

Address: 8171 PRINCE EDWARD CRES

Sanitary Connection: # SIZE 4" MATERIAL ^{WT}PVC INV. CONNECTED

Water Connection # SIZE 3/4" MATERIAL COPPER METER CONNECTED

Storm Connection: # SIZE 4" MATERIAL ~~CP~~PVC INV. CONNECTED

Cash Receipt No's: WATER SANITARY STORM

CURB FROM PROPERTY LINE 16' PAVEMENT WIDTH 34'

B.C. HYDRO 3' UNDERGROUND CONNECTION


B.C. TELEPHONE 3' UNDERGROUND CONNECTION

INLAND GAS 10


Information Sheets:

Comments: 66' R/W

The information contained herein is for internal use only. Not to be relied upon unless confirmed by site inspection and/or investigation.

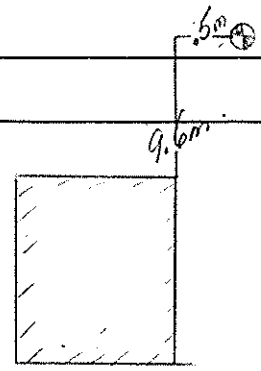

SITE PLAN N.T.S.
LOT 6
W.S.H.
10.2
5.0
5.5
C.S.

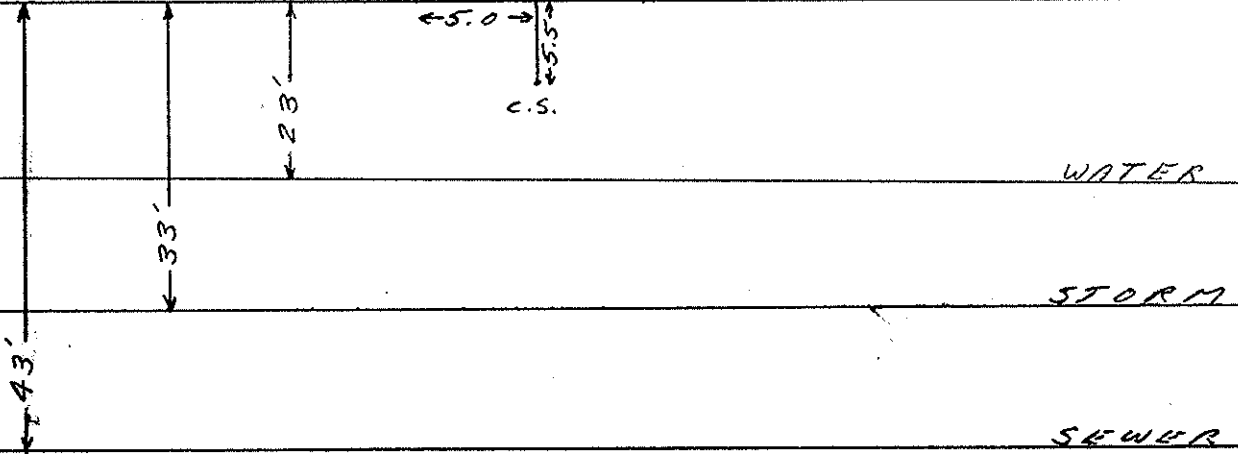

[Handwritten signature]