



CITY OF
PRINCE GEORGE

City of Prince George HISTORY SHEET

PID:	032-239-211
SD/MU:	
WO:	

CIVIC ADDRESS: 3084 DEDDO CRT

LEGAL DESCRIPTION: LOT 36 DISTRICT LOT: 4050 PLAN: EPP124362

SERVICE TYPE	DIAMETER (mm)	MATERIAL	INVERT ELEV AT MAIN (m)	INVERT ELEV AT PROPERTY LINE (m)	INVERT ELEV AT SERVICE END (m)	COVER AT PROPERTY LINE (m)	DISTANCE INTO PROPERTY (m)	INSTALLATION DATE
SANITARY	100	PVC	603.30	603.83	603.88	2.07	3.0	APRIL 2022
WATER	19	COPPER	602.80	603.68	603.78	2.30	3.0	APRIL 2022
STORM	N/A	N/A	N/A	N/A	N/A	N/A	N/A	N/A

ELECTRICAL / COMMUNICATIONS / GAS

TYPE	PROVIDER	SIZE AND MATERIAL	LOCATION (UNDERGROUND/ OVERHEAD)
ELECTRICAL	BC HYDRO	75mm DB2	UNDERGROUND
COMMUNICATION	TELUS	50mm DB2	UNDERGROUND
COMMUNICATION	SHAW	50mm DB2	UNDERGROUND
GAS	FORTISBC	42 PROP/P.E.	UNDERGROUND


INFORMATION SHEETS: L&M ENGINEERING LIMITED PROJECT NUMBER 1145-29

SURVEY DATE: APRIL 2022

INSTALLED BY: JOE ROBERTS CONSTRUCTION & CONSULTING SERVICES LTD.

COMMENTS:

THE INFORMATION CONTAINED HEREIN IS FOR INTERNAL USE ONLY.
NOT TO BE RELIED UPON UNLESS CONFIRMED BY SITE INVESTIGATION.

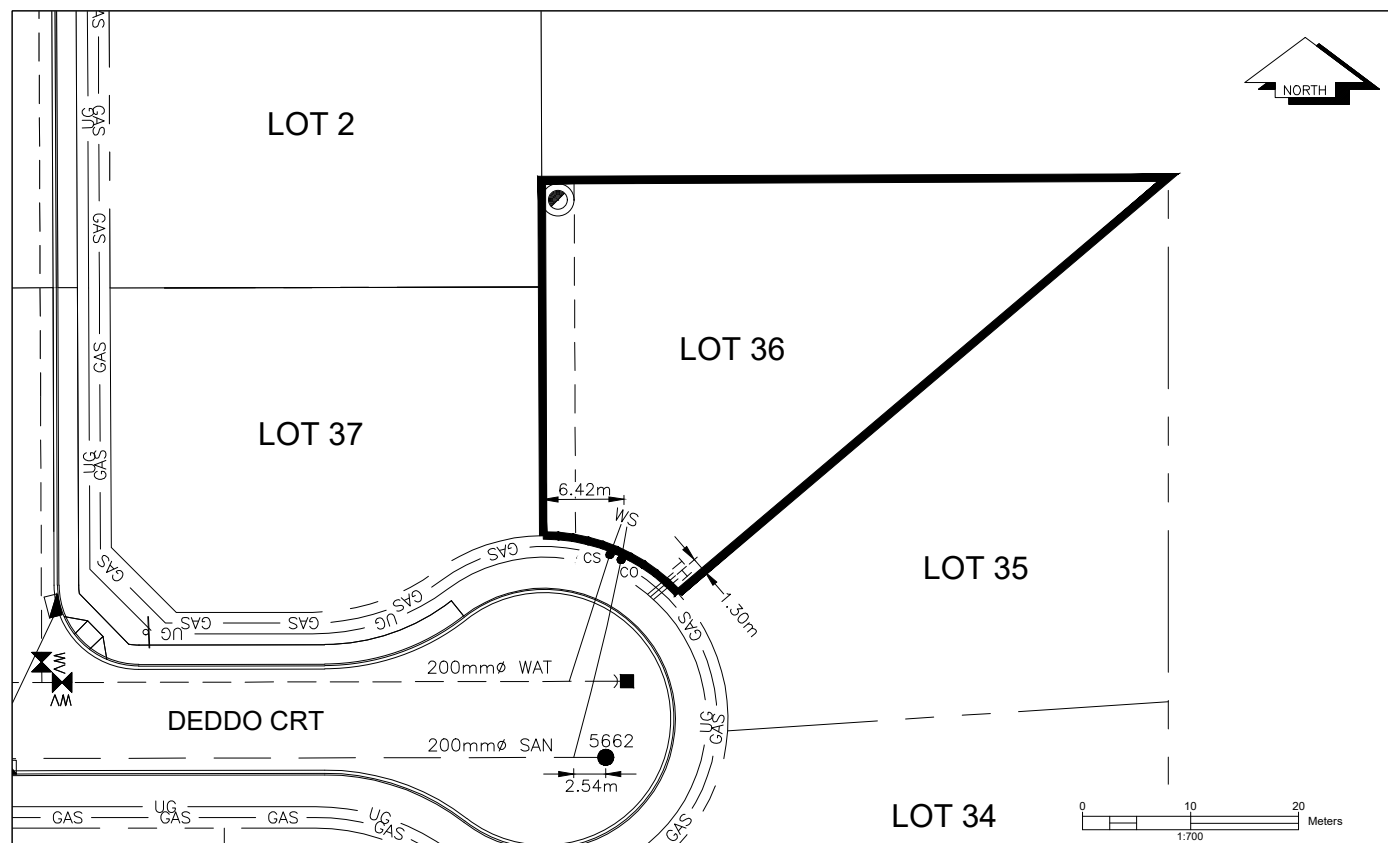

LEGEND:

CS CURB STOP
CO CLEAN OUT

W WATER SERVICE
S D W STORM SERVICE
S SANITARY SERVICE

HYDRO SERVICE
TELECOMMUNICATIONS

GAS GAS
UG SHALLOW UTILITIES