



City of Prince George HISTORY SHEET

CITY OF
PRINCE GEORGE

PID:	032-239-238
SD/MU:	
WO:	

CIVIC ADDRESS: 4625 MARBLE ST


LEGAL DESCRIPTION: LOT 38 DISTRICT LOT: 4050 PLAN: EPP124362

SERVICE TYPE	DIAMETER (mm)	MATERIAL	INVERT ELEV AT MAIN (m)	INVERT ELEV AT PROPERTY LINE (m)	INVERT ELEV AT SERVICE END (m)	COVER AT PROPERTY LINE (m)	DISTANCE INTO PROPERTY (m)	INSTALLATION DATE
SANITARY	100	PVC	602.17	602.52	602.58	2.64	3.0	APRIL 2022
WATER	19	COPPER	602.19	602.52	602.60	2.72	3.0	APRIL 2022
STORM	N/A	N/A	N/A	N/A	N/A	N/A	N/A	N/A

ELECTRICAL / COMMUNICATIONS / GAS			
TYPE	PROVIDER	SIZE AND MATERIAL	LOCATION (UNDERGROUND/ OVERHEAD)
ELECTRICAL	BC HYDRO	75mm DB2	UNDERGROUND
COMMUNICATION	TELUS	50mm DB2	UNDERGROUND
COMMUNICATION	SHAW	50mm DB2	UNDERGROUND
GAS	FORTISBC	42 PROP/P.E.	UNDERGROUND

INFORMATION SHEETS: L&M ENGINEERING LIMITED PROJECT NUMBER 1145-29	SURVEY DATE: APRIL 2022
INSTALLED BY: JOE ROBERTS CONSTRUCTION & CONSULTING SERVICES LTD.	
COMMENTS:	

THE INFORMATION CONTAINED HEREIN IS FOR INTERNAL USE ONLY.
NOT TO BE RELIED UPON UNLESS CONFIRMED BY SITE INVESTIGATION.

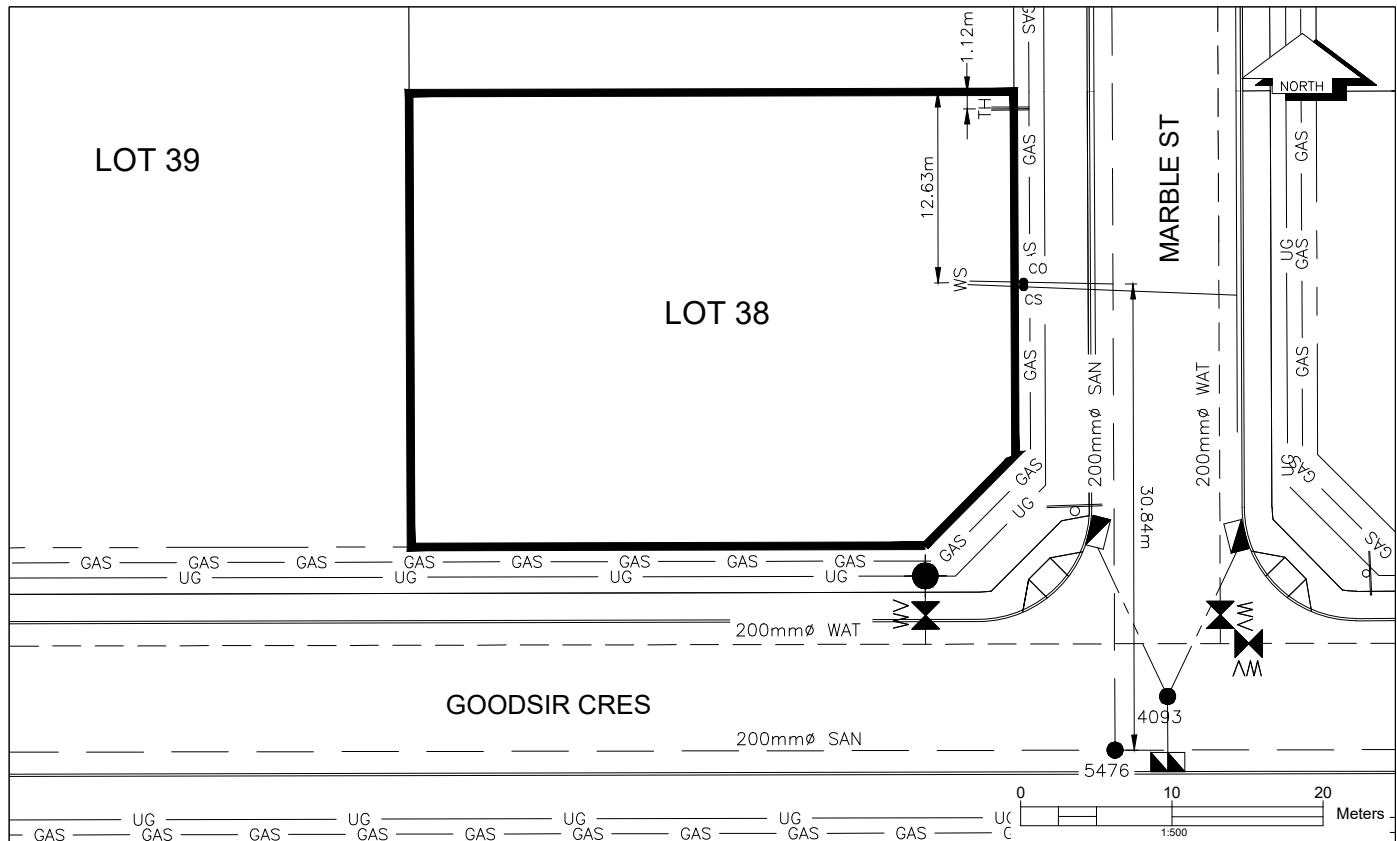

LEGEND:	<ul style="list-style-type: none"> CS ● CURB STOP CO ● CLEAN OUT — W — WATER SERVICE — S D W — STORM SERVICE — S — SANITARY SERVICE 	<ul style="list-style-type: none"> — H — HYDRO SERVICE — T — TELECOMMUNICATIONS — GAS — GAS — UG — GAS SHALLOW UTILITIES
----------------	--	--