



CITY OF
PRINCE GEORGE

City of Prince George HISTORY SHEET

PID:	032-239-343
SD/MU:	
WO:	

CIVIC ADDRESS: 4745 FOSSIL CRES


LEGAL DESCRIPTION: LOT 49 DISTRICT LOT: 4050 PLAN: EPP124362

SERVICE TYPE	DIAMETER (mm)	MATERIAL	INVERT ELEV AT MAIN (m)	INVERT ELEV AT PROPERTY LINE (m)	INVERT ELEV AT SERVICE END (m)	COVER AT PROPERTY LINE (m)	DISTANCE INTO PROPERTY (m)	INSTALLATION DATE
SANITARY	100	PVC	602.24	602.78	602.81	2.37	3.0	AUGUST 2018
WATER	19	COPPER	602.25	602.80	602.83	2.44	3.0	AUGUST 2018
STORM	N/A	N/A	N/A	N/A	N/A	N/A	N/A	N/A

ELECTRICAL / COMMUNICATIONS / GAS			
TYPE	PROVIDER	SIZE AND MATERIAL	LOCATION (UNDERGROUND/ OVERHEAD)
ELECTRICAL	BC HYDRO	75mm DB2	UNDERGROUND
COMMUNICATION	TELUS	50mm DB2	UNDERGROUND
COMMUNICATION	SHAW	50mm DB2	UNDERGROUND
GAS	FORTISBC	42 PROP/P.E.	UNDERGROUND

INFORMATION SHEETS: L&M ENGINEERING LIMITED PROJECT NUMBER 1145-29	SURVEY DATE: AUGUST 2018
INSTALLED BY: NAKIB CONSTRUCTION LTD.	
COMMENTS:	

THE INFORMATION CONTAINED HEREIN IS FOR INTERNAL USE ONLY.
NOT TO BE RELIED UPON UNLESS CONFIRMED BY SITE INVESTIGATION.

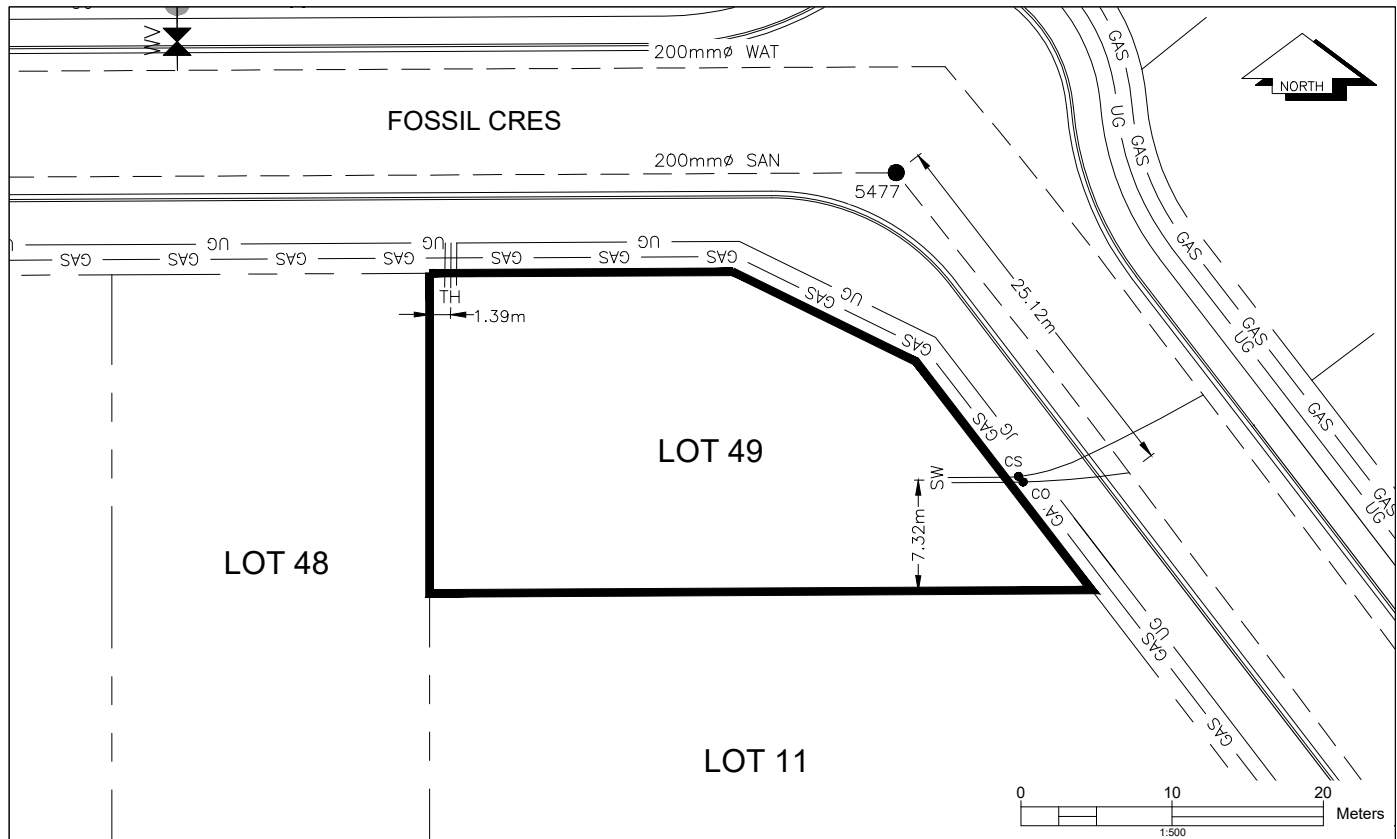

LEGEND:	CS ● CURB STOP	— S D W WATER SERVICE	— H HYDRO SERVICE	— GAS GAS	— UG GAS SHALLOW UTILITIES
	CO ● CLEAN OUT	— S D W STORM SERVICE	— T TELECOMMUNICATIONS		
		— S D W SANITARY SERVICE			