

City of Prince George
HISTORY SHEET

(2 pages)

SHEET NUMBER No 2107

Roll Number

Legal: LOT A, DISTRICT LOT 343, CARIBOO DISTRICT, PLAN EPP122034

Address: 1800 UPLAND ST

Sanitary Connection: # 7602 SIZE 4" MATERIAL A.C. INV. CONNECTED

Water Connection # 1818 SIZE 1/2" MATERIAL METER CONNECTED

Storm Connection: # SIZE MATERIAL INV. CONNECTED

Cash Receipt No's: WATER SANITARY STORM

CURB FROM PROPERTY LINE

PAVEMENT WIDTH

B.C. HYDRO

UNDERGROUND CONNECTION

B.C. TELEPHONE

UNDERGROUND CONNECTION


INLAND GAS

Information Sheets:

Comments:

The information contained herein is
for internal use only. Not to be
relied upon unless confirmed by site
inspection and/or investigation.



Lots consolidated into Lot A, District Lot 343,
Cariboo District, Plan EPP122034

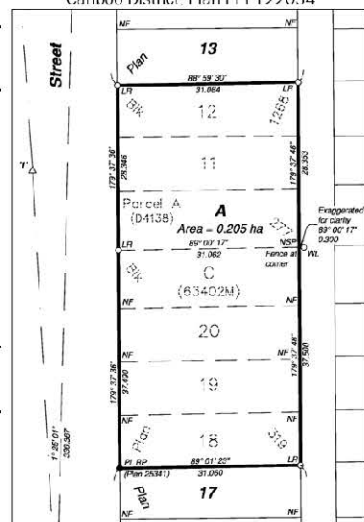

SITE

PLAN

N.T.S.

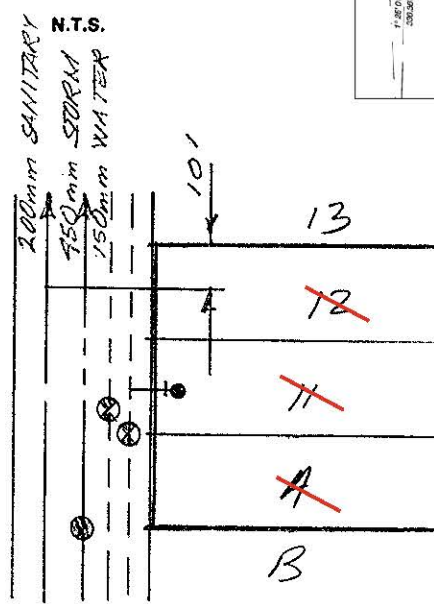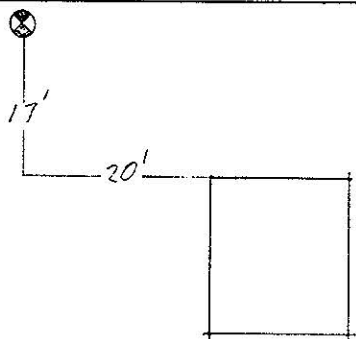

CANCELLED PIDs
011857536 (Lot 12)
011857480 (Lot 11)
011234814 (Pct A)

City of Prince George
HISTORY SHEET

SHEET NUMBER **Nº 2140** (2 pages) Roll Number

Legal: **LOT A, DISTRICT LOT 343, CARIBOO DISTRICT, PLAN EPP122034**

Address: **1800 UPLAND ST**

Sanitary Connection: #	7606	SIZE	4"	MATERIAL	INV.	CONNECTED
	7607		4"			
Water Connection #	7628	SIZE	3/4"	MATERIAL	METER	CONNECTED
	706		1/2"	COPPER		
Storm Connection: #		SIZE		MATERIAL	INV.	CONNECTED

Cash Receipt No's: WATER SANITARY STORM

CURB FROM PROPERTY LINE PAVEMENT WIDTH

B.C. HYDRO UNDERGROUND CONNECTION

B.C. TELEPHONE UNDERGROUND CONNECTION




INLAND GAS

Information Sheets:

Comments:

The information contained herein is
for internal use only. Not to be
relied upon unless confirmed by site
inspection and/or investigation.

SITE PLAN N.T.S.

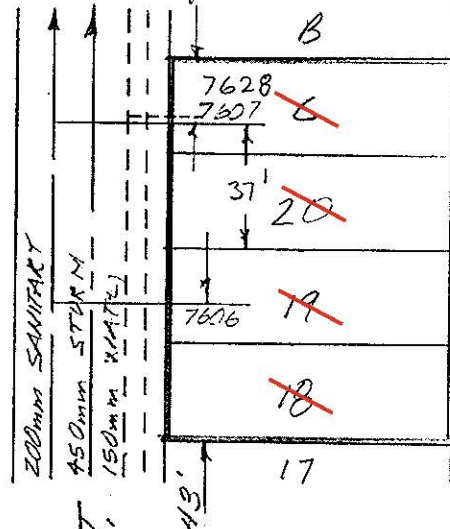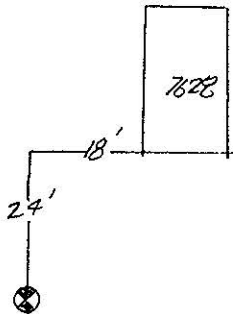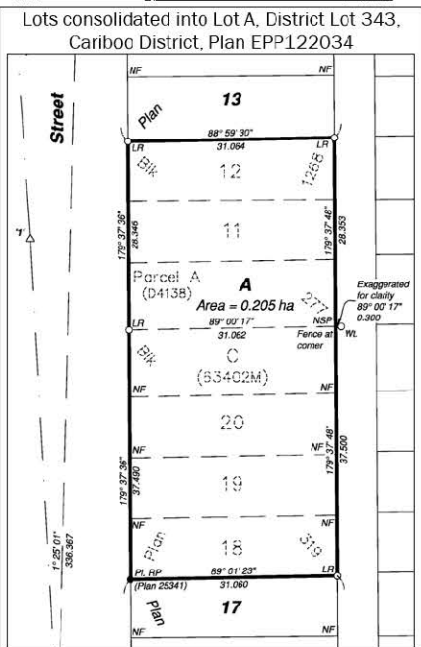

CANCELLED PIDs

010074333 (Lot C)

010074422 (Lot 20)

010074414 (Lot 19)

010074368 (Lot 18)