

City of Prince George
HISTORY SHEET

SHEET NUMBER

5527

Roll Number

Parcel 1 (CB1571555)

Legal:

LOT'S

~~A & B~~

BLOCK

D.L.

343

PLAN

20220

Address:

1550 VICTORIA ST.

Sanitary Connection: #

SIZE

MATERIAL

INV.

CONNECTED

#

6990

6"

#406

Water Connection

SIZE

MATERIAL

METER

CONNECTED

Storm Connection: #

SIZE

MATERIAL

INV.

CONNECTED

1231

12"

Cash Receipt No's:

WATER

SANITARY

STORM

CURB FROM PROPERTY LINE

PAVEMENT WIDTH

B.C. HYDRO

UNDERGROUND CONNECTION

B.C. TELEPHONE


UNDERGROUND CONNECTION

INLAND GAS


Information Sheets:

Comments:

The City of Prince George does not represent or guarantee that the information contained in this document is accurate or reliable, and any person who relies on this information in this document does so at their own risk.

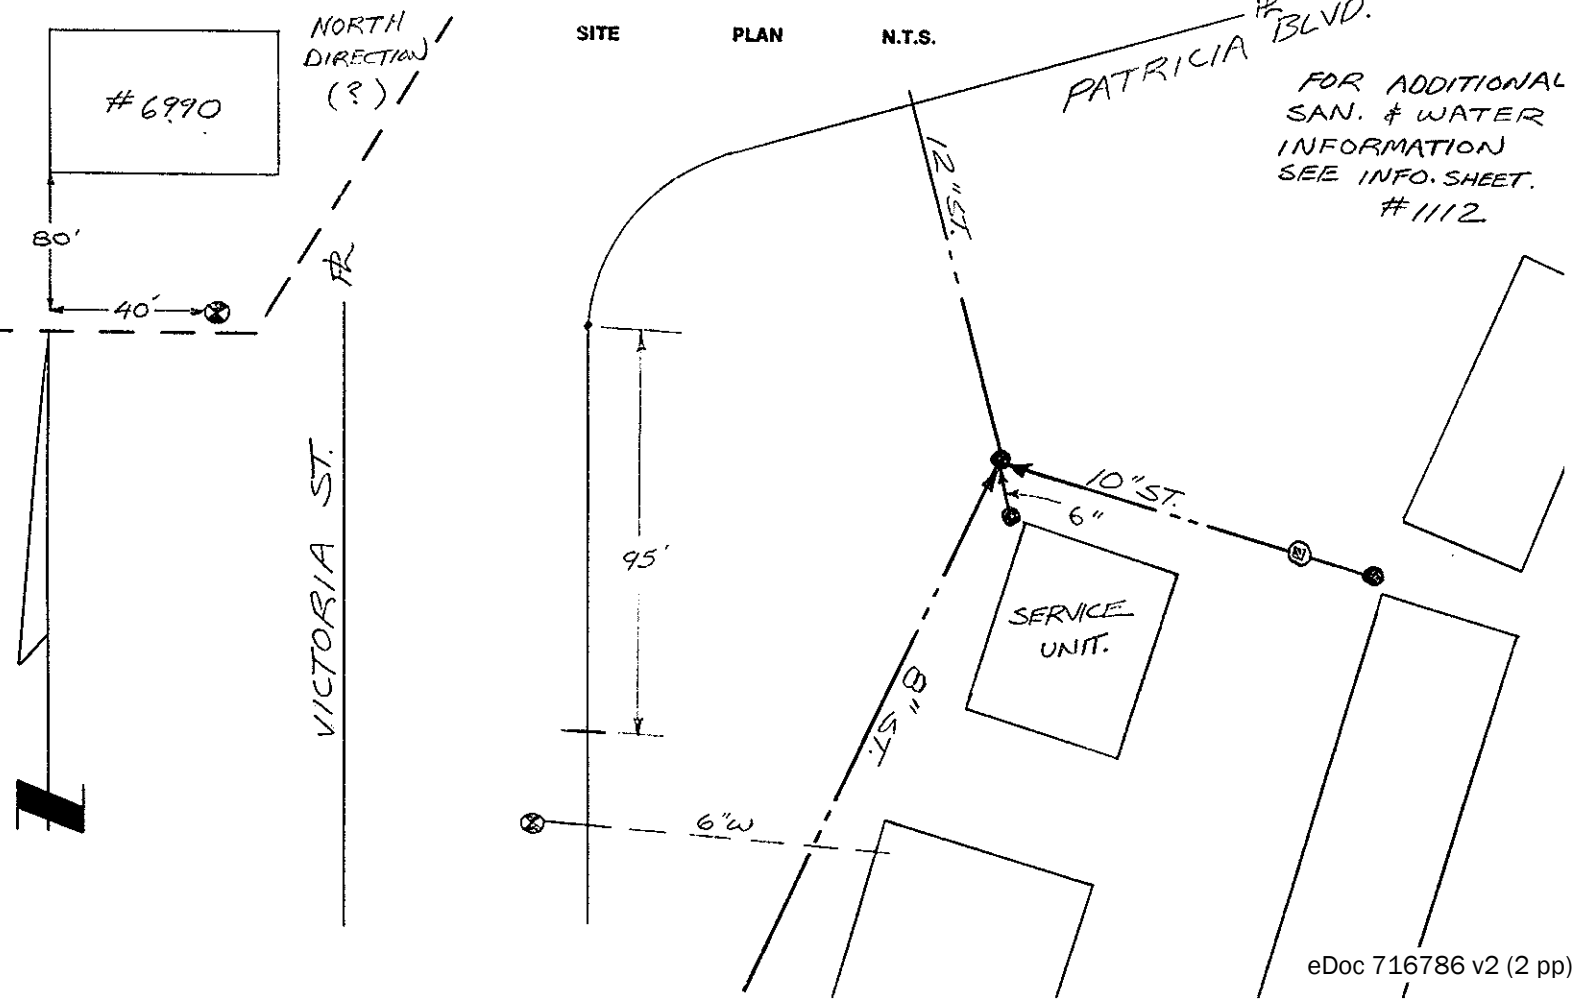

The City of Prince George does not represent or guarantee that the information contained in this document is accurate or reliable, and any person who relies on this information in this document does so at their own risk.

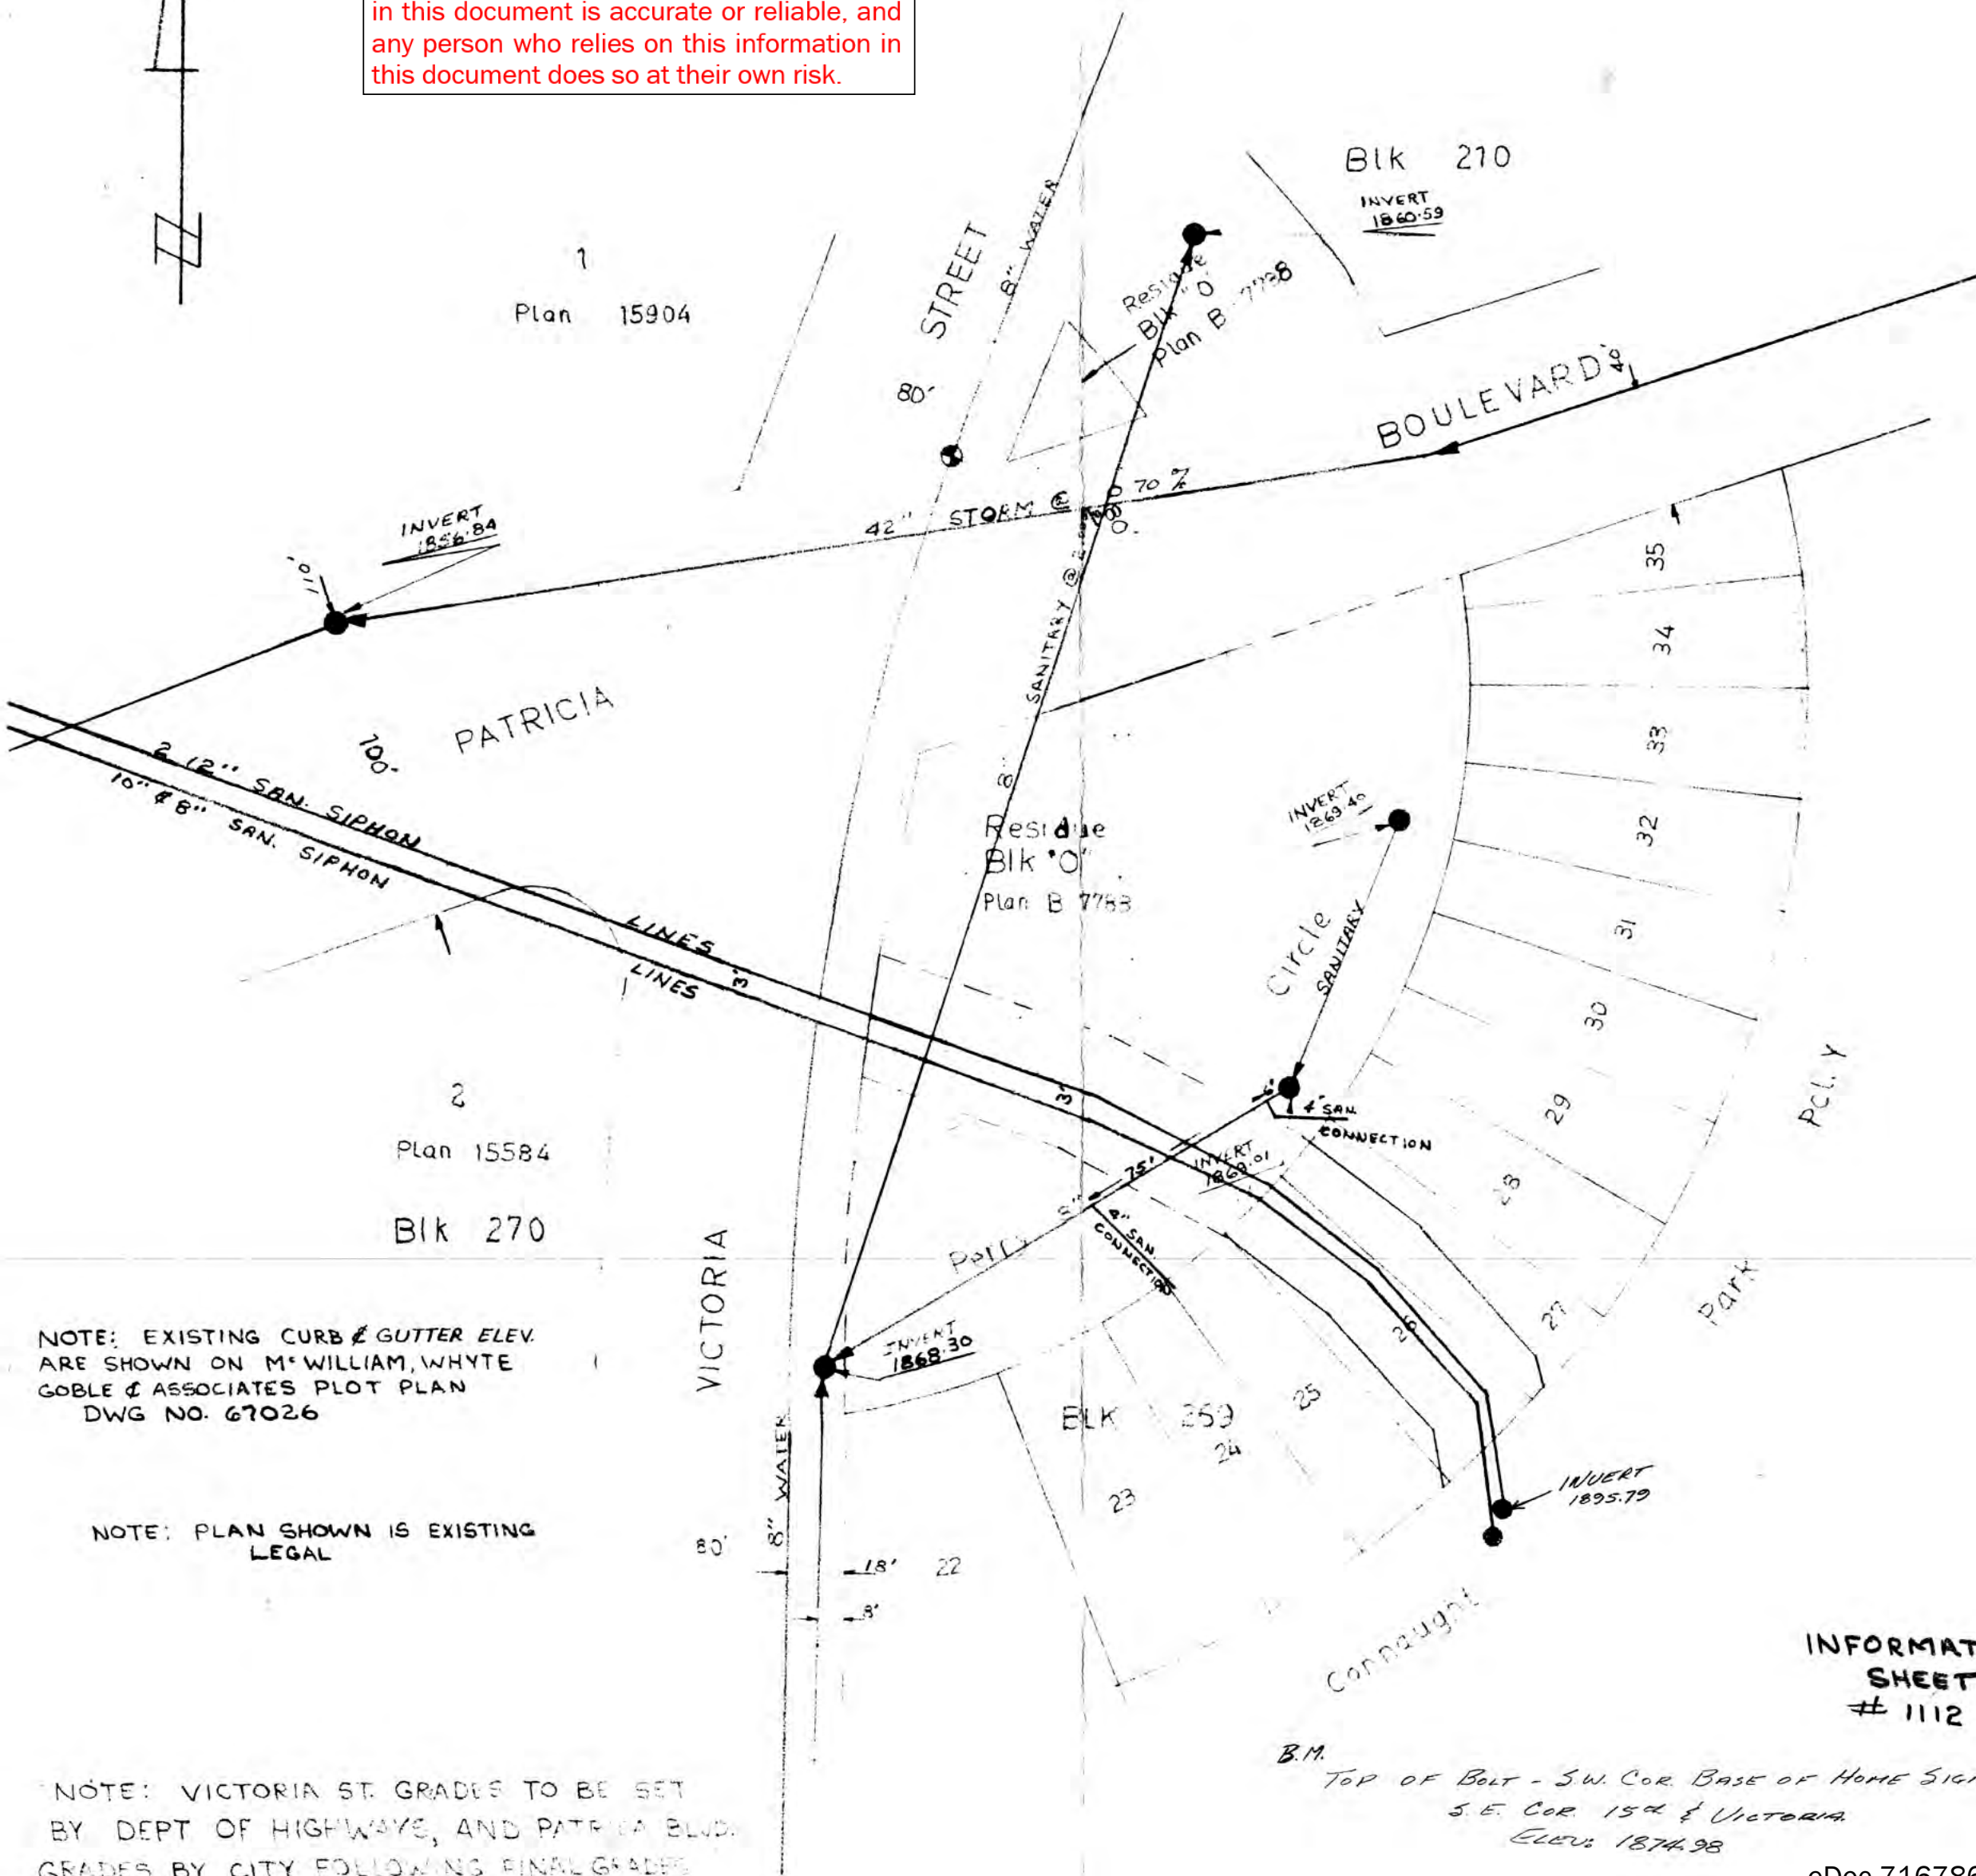

NOTE: EXISTING CURB & GUTTER ELEV. ARE SHOWN ON M^r WILLIAM, WHYTE GOBLE & ASSOCIATES PLOT PLAN DWG NO. 67026

NOTE: PLAN SHOWN IS EXISTING LEGAL

NOTE: VICTORIA ST. GRADES TO BE SET BY DEPT OF HIGHWAYS, AND PATRICIA BLVD. GRADES BY CITY FOLLOWING FINAL GRADES ON VICTORIA ST.

INFORMATION SHEET # 1112

B.M.
TOP OF BOLT - S.W. COR. BASE OF HOME SIGN.
S.E. COR. 15th & VICTORIA
ELEV: 1874.98