



CITY OF
PRINCE GEORGE

City of Prince George HISTORY SHEET

PID:	032-353-481
SD/MU:	SD100683
WO:	

CIVIC ADDRESS: 4316 PROMONTORY DR


LEGAL DESCRIPTION: LOT 16 DISTRICT LOT 2616 PLAN EPP137928

SERVICE TYPE	DIAMETER (mm)	MATERIAL	INVERT ELEV AT MAIN (m)	INVERT ELEV AT PROPERTY LINE (m)	INVERT ELEV AT SERVICE END (m)	COVER AT PROPERTY LINE (m)	DISTANCE INTO PROPERTY (m)	INSTALLATION DATE
SANITARY	100	PVC	772.46	772.86	772.96	2.52	3.00	AUGUST 2023
WATER	19	COPPER	771.67	772.85	772.88	2.45	3.00	AUGUST 2023
STORM	100	PVC	771.69	772.84	772.93	2.54	3.00	AUGUST 2023

ELECTRICAL / COMMUNICATIONS / GAS			
TYPE	PROVIDER	SIZE AND MATERIAL	LOCATION (UNDERGROUND/ OVERHEAD)
ELECTRICAL	BC HYDRO	75mm DB2	UNDERGROUND
COMMUNICATION	TELUS	50mm DB2	UNDERGROUND
COMMUNICATION	SHAW	50mm DB2	UNDERGROUND
GAS	FORTISBC	42 PROP/P.E.	UNDERGROUND

INFORMATION SHEETS: L&M ENGINEERING LIMITED PROJECT NUMBER 1273-27	SURVEY DATE: AUGUST 2023
INSTALLED BY: JOE ROBERTS CONSTRUCTION & CONSULTING SERVICES LTD.	
COMMENTS:	

THE INFORMATION CONTAINED HEREIN IS FOR INTERNAL USE ONLY.
NOT TO BE RELIED UPON UNLESS CONFIRMED BY SITE INVESTIGATION.

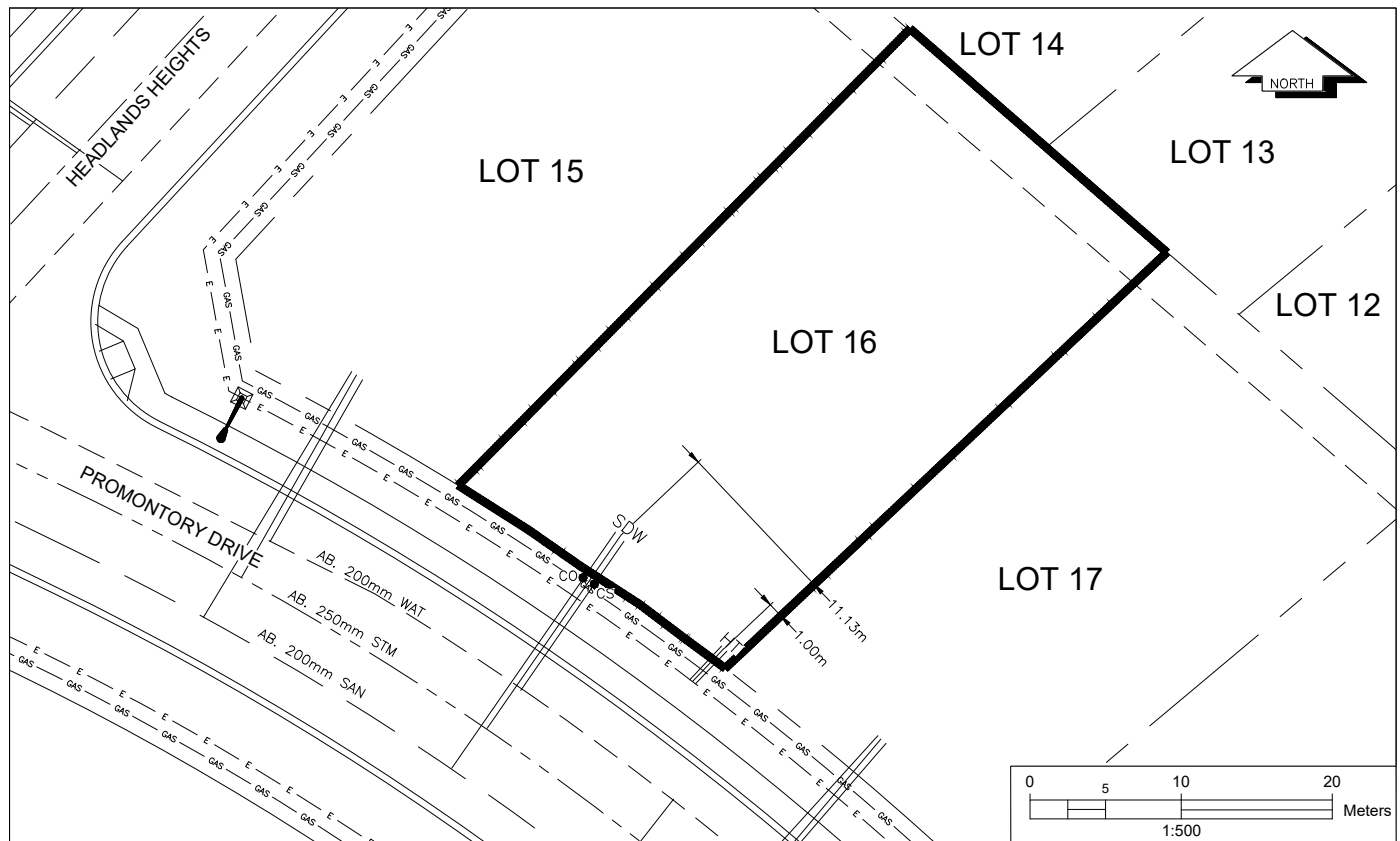

LEGEND:	CS. CURB STOP	SDW WATER SERVICE	HYDRO SERVICE	GAS GAS
	CO. CLEAN OUT	SDW STORM SERVICE	TELECOMMUNICATIONS	E ELECTRICAL
		SDW SANITARY SERVICE		