



CITY OF
PRINCE GEORGE

City of Prince George HISTORY SHEET

PID:	032-353-669
SD/MU:	SD100683
WO:	

CIVIC ADDRESS: 5242 HEADLANDS HEIGHTS


LEGAL DESCRIPTION: LOT 34 DISTRICT LOT 2616. PLAN EPP137928.

SERVICE TYPE	DIAMETER (mm)	MATERIAL	INVERT ELEV AT MAIN (m)	INVERT ELEV AT PROPERTY LINE (m)	INVERT ELEV AT SERVICE END (m)	COVER AT PROPERTY LINE (m)	DISTANCE INTO PROPERTY (m)	INSTALLATION DATE
SANITARY	100	PVC	775.39	775.66	775.72	2.58	3.00	AUGUST 2023
WATER	19	COPPER	774.71	775.66	775.65	2.50	3.00	AUGUST 2023
STORM	100	PVC	775.44	775.76	775.72	2.58	3.00	AUGUST 2023

ELECTRICAL / COMMUNICATIONS / GAS			
TYPE	PROVIDER	SIZE AND MATERIAL	LOCATION (UNDERGROUND/ OVERHEAD)
ELECTRICAL	BC HYDRO	75mm DB2	UNDERGROUND
COMMUNICATION	TELUS	50mm DB2	UNDERGROUND
COMMUNICATION	SHAW	50mm DB2	UNDERGROUND
GAS	FORTISBC	42 PROP/P.E.	UNDERGROUND

INFORMATION SHEETS: L&M ENGINEERING LIMITED PROJECT NUMBER 1273-27	SURVEY DATE: AUGUST 2023
INSTALLED BY: JOE ROBERTS CONSTRUCTION & CONSULTING SERVICES LTD.	
COMMENTS:	

THE INFORMATION CONTAINED HEREIN IS FOR INTERNAL USE ONLY.
NOT TO BE RELIED UPON UNLESS CONFIRMED BY SITE INVESTIGATION.

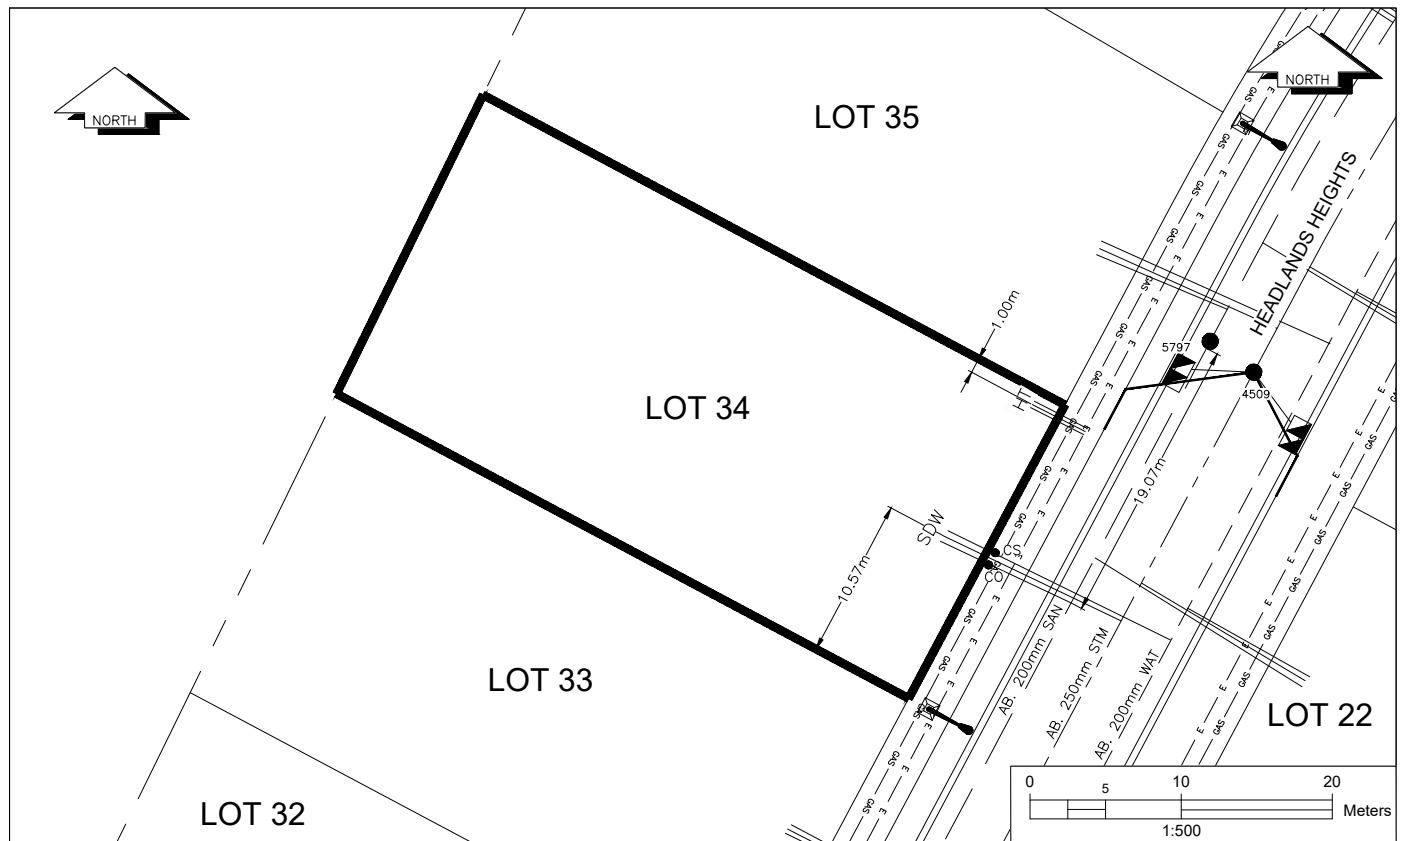

LEGEND:	CS CURB STOP	W WATER SERVICE	H HYDRO SERVICE	G GAS
	CO CLEAN OUT	S STORM SERVICE	T TELECOMMUNICATIONS	E ELECTRICAL
		S SANITARY SERVICE		