



CITY OF  
PRINCE GEORGE

## City of Prince George HISTORY SHEET

|        |             |
|--------|-------------|
| PID:   | 032-353-863 |
| SD/MU: | SD100683    |
| WO:    |             |

CIVIC ADDRESS: 4988 HEADLANDS HEIGHTS


LEGAL DESCRIPTION: LOT 54 DISTRICT LOT 2616 PLAN EPP137928

| SERVICE TYPE | DIAMETER (mm) | MATERIAL | INVERT ELEV AT MAIN (m) | INVERT ELEV AT PROPERTY LINE (m) | INVERT ELEV AT SERVICE END (m) | COVER AT PROPERTY LINE (m) | DISTANCE INTO PROPERTY (m) | INSTALLATION DATE |
|--------------|---------------|----------|-------------------------|----------------------------------|--------------------------------|----------------------------|----------------------------|-------------------|
| SANITARY     | 100           | PVC      | 756.69                  | 757.18                           | 757.24                         | 2.35                       | 3.00                       | AUGUST 2023       |
| WATER        | 19            | COPPER   | 756.23                  | 757.10                           | 757.20                         | 2.35                       | 3.00                       | AUGUST 2023       |
| STORM        | 100           | PVC      | 756.64                  | 757.20                           | 757.20                         | 2.33                       | 3.00                       | AUGUST 2023       |

| ELECTRICAL / COMMUNICATIONS / GAS |          |                   |                                   |
|-----------------------------------|----------|-------------------|-----------------------------------|
| TYPE                              | PROVIDER | SIZE AND MATERIAL | LOCATION ( UNDERGROUND/ OVERHEAD) |
| ELECTRICAL                        | BC HYDRO | 75mm DB2          | UNDERGROUND                       |
| COMMUNICATION                     | TELUS    | 50mm DB2          | UNDERGROUND                       |
| COMMUNICATION                     | SHAW     | 50mm DB2          | UNDERGROUND                       |
| GAS                               | FORTISBC | 42 PROP/P.E.      | UNDERGROUND                       |

|                                                                    |                          |
|--------------------------------------------------------------------|--------------------------|
| INFORMATION SHEETS: L&M ENGINEERING LIMITED PROJECT NUMBER 1273-27 | SURVEY DATE: AUGUST 2023 |
| INSTALLED BY: JOE ROBERTS CONSTRUCTION & CONSULTING SERVICES LTD.  |                          |
| COMMENTS:                                                          |                          |

THE INFORMATION CONTAINED HEREIN IS FOR INTERNAL USE ONLY.  
NOT TO BE RELIED UPON UNLESS CONFIRMED BY SITE INVESTIGATION.

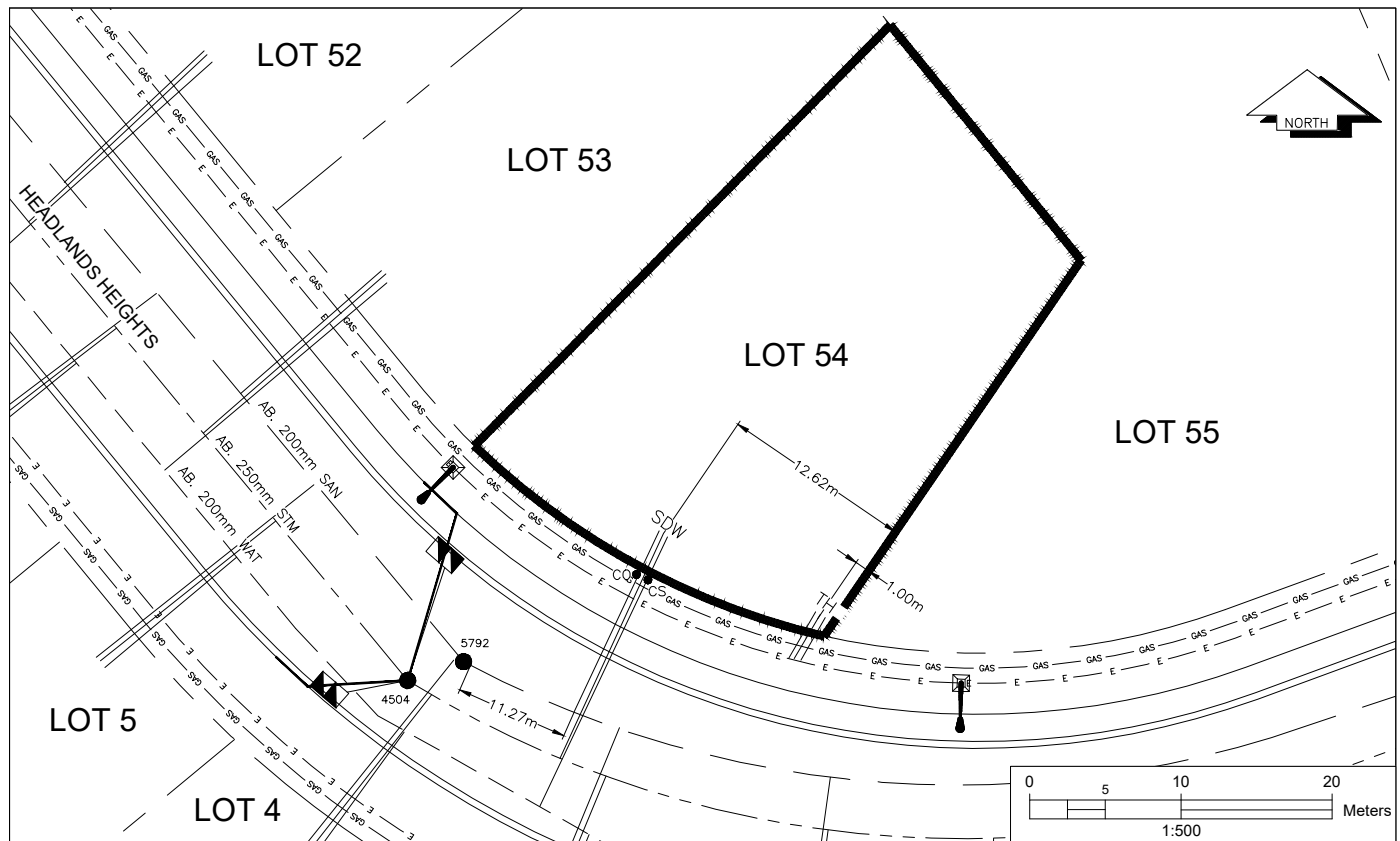

| LEGEND:        |                          |                        |                |
|----------------|--------------------------|------------------------|----------------|
| CS ● CURB STOP | — W WATER SERVICE        | — H HYDRO SERVICE      | — GAS GAS      |
| CO ● CLEAN OUT | — S D W STORM SERVICE    | — T TELECOMMUNICATIONS | — E ELECTRICAL |
|                | — S D W SANITARY SERVICE |                        |                |