

City of Prince George
HISTORY SHEET

~~00643919~~

SHEET NUMBER _____ Roll Number _____

Legal: **Parcel C (CB1742134)**
LOT'S ~~16~~ BLOCK _____ D.L. **4039** PLAN **27675**

Address: **2262 Knell Rd E** ~~2294 KNELL ROAD~~

Sanitary Connection: # _____ SIZE **100 mm** MATERIAL **P.V.C.** INV. **656.01 M** CONNECTED

Water Connection # _____ SIZE **25.4 mm** MATERIAL **COPPER** METER _____ CONNECTED

Storm Connection: # _____ SIZE **150 mm** MATERIAL **PVC** INV. **656.60 M** CONNECTED

Cash Receipt No's: WATER _____ SANITARY _____ STORM _____

CURB FROM PROPERTY LINE **3.5 M (ERECT CURB)** PAVEMENT WIDTH **13.0 M**

B.C. HYDRO **OVERHEAD** ~~UNDERGROUND~~ CONNECTION


B.C. TELEPHONE **OVERHEAD** ~~UNDERGROUND~~ CONNECTION

INLAND GAS _____

Information Sheets: _____

THE INFORMATION CONTAINED HEREIN IS FOR INTERNAL USE ONLY. NOT TO BE RELIED UPON UNLESS CONFIRMED BY SITE INSPECTION AND/OR INVESTIGATION.

Comments: _____

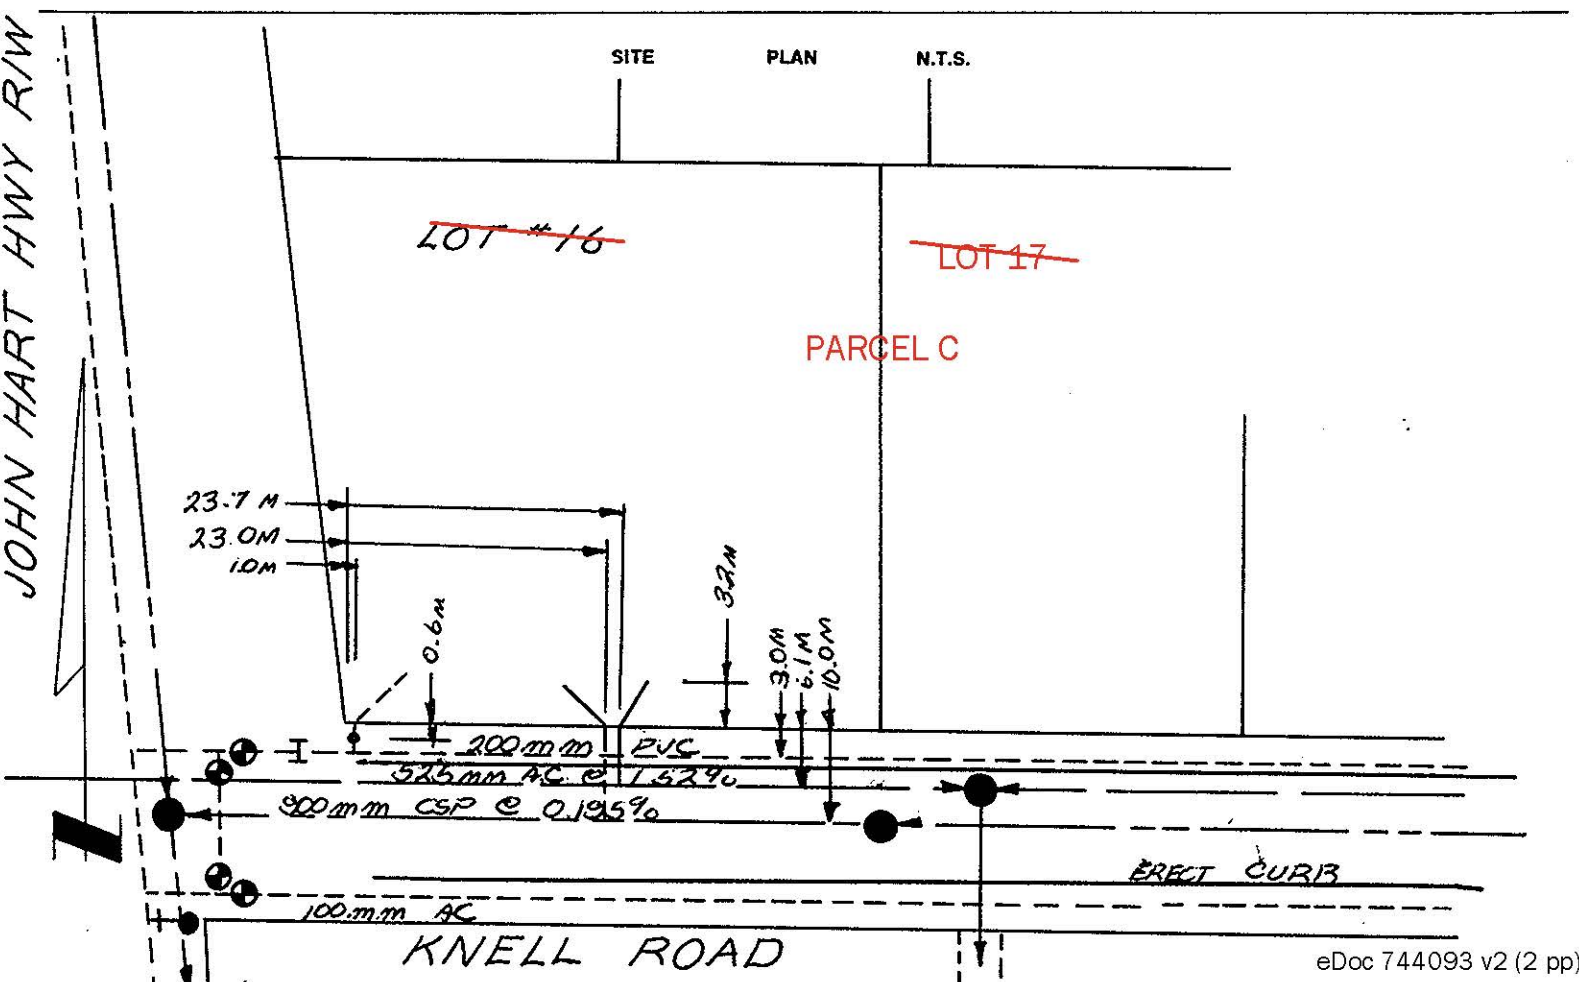

City of Prince George
HISTORY SHEET

~~006413927~~

SHEET NUMBER _____ Roll Number _____

Legal: **Parcel C (CB1742134)** LOT'S ~~17~~ BLOCK _____ D.L. **4039** PLAN **27675**

Address: **2262 KNELL ROAD**

Sanitary Connection: # _____ SIZE **100 mm** MATERIAL **P.V.C.** INV. **656.74** CONNECTED

Water Connection # _____ SIZE **25.4 mm** MATERIAL **COPPER** METER _____ CONNECTED

Storm Connection: # _____ SIZE **150 mm** MATERIAL **P.V.C.** INV. **656.62** CONNECTED

Cash Receipt No's: WATER _____ SANITARY _____ STORM _____

CURB FROM PROPERTY LINE **3.5 M (ERECT CURB)** PAVEMENT WIDTH **13.0 M**

B.C. HYDRO **OVER HEAD** ~~UNDERGROUND~~ CONNECTION

B.C. TELEPHONE **OVER HEAD** ~~UNDERGROUND~~ CONNECTION

INLAND GAS _____

Information Sheets: _____

Comments: _____
THE INFORMATION CONTAINED HEREIN IS FOR INTERNAL USE ONLY. NOT TO BE RELIED UPON UNLESS CONFIRMED BY SITE INSPECTION AND/OR INVESTIGATION.

