



City of Prince George

PID:	005437580
	005437601
	005437628
SD/MU:	
WC:	

History Sheet

Civic Address: 2609 Gunn Road

Legal Description: ~~Lot: 48 District Lot: 629 Plan: 902~~

~~Lot: 47 District Lot: 629 Plan: 902~~

~~Lot: 46 District Lot: 629 Plan: 902~~

PARCEL D (BEING A CONSOLIDATION OF LOTS 45 TO 48, SEE CB1748496),
BLOCK 63, DISTRICT LOT 629, CARIBOO DISTRICT, PLAN 902


Service Type	Diameter (mm)	Material	Invert Elev at main (m)	Invert Elev at property line (m)	Invert Depth at service end (m)	Distance into property (m)	Installation Date
Sanitary	100mm	AC	-	689.75	2.74	-	January 1976
Water	Unknown	Unknown	-	-	-	-	April 1998
Storm	N/A	N/A	-	-	-	-	

Service Connection Location				Sanitary (m)	Storm (m)
Distance from downstream San MH	2883	towards upstream San MH	2882	58.87	
Distance from downstream Stm MH	-	towards upstream Stm MH	-		

Power	Size	Communications	Size	Cable	Size	Gas	Size
BC Hydro	-	Telus	-	Shaw	-	FortisBC	-
Overhead Service		Overhead Service		Overhead Service			

Installed by:	Survey Date:	-
Comments:		

NOT TO SCALE The information contained herein is for internal use only.
Not to be relied on unless confirmed by site inspection and/or investigation.

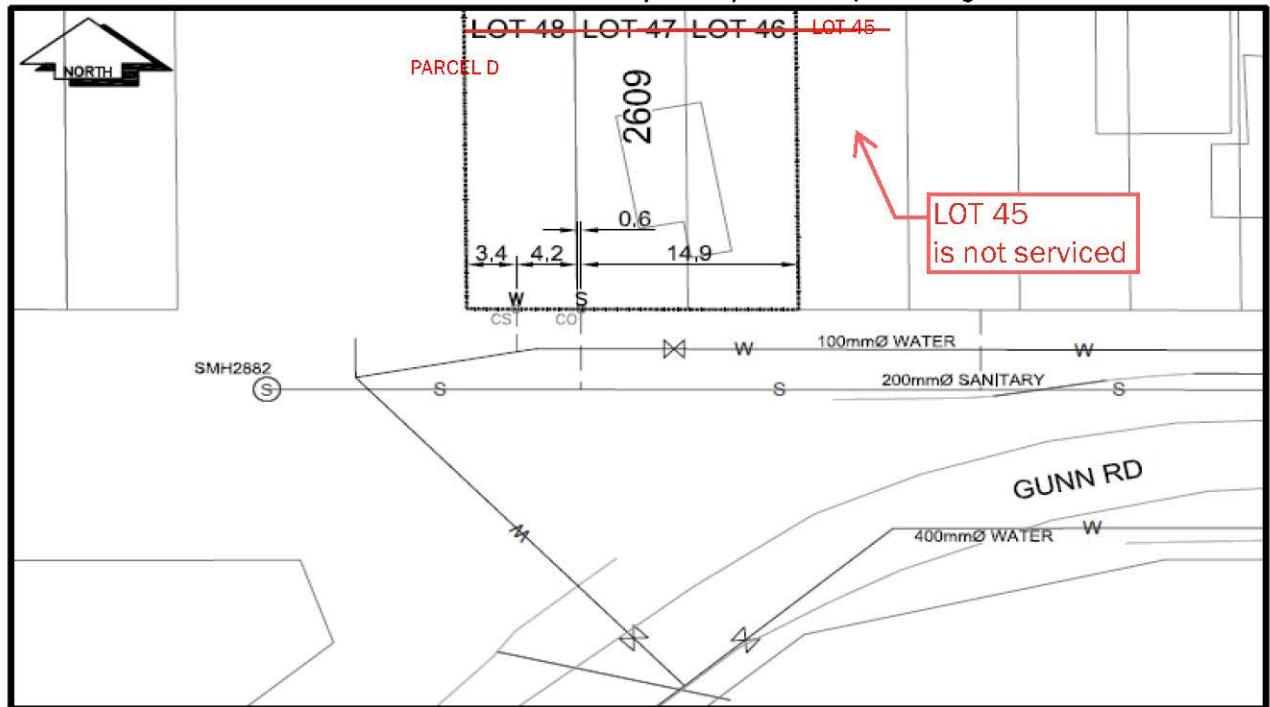

Card No.	Unit	House	Street	Propert...	Service Type	Material Type	Service Size	Meter No.	Location
008336		2609	GUNN RD	111491	SANITARY	AC	100MM		8.2M E OF SW COR PL OF LOT 48 (0.6M E OF SW COR OF LOT 47) - 21.64M FR M.H. TO CONNECTION
069714		2609	GUNN RD	111491	WATER	UNKNOWN	UNKNOWN		3.4M E OF SW COR PL OF LOT 48

NOT TO SCALE