

City of Prince George

HISTORY SHEET

032431317

PID: ~~029-734-746~~ 032-431-317

Scale: 1:500

Legal: ~~LOT 2~~ Lot A

D.L.: 1433

PLAN: ~~EPP55599~~ EPP139192

Address: 2997 ELLINGTON AVE

Sanitary Connection.#	SIZE:	100mmØ	MATERIAL:	PVC	INV.	651.19m	CONNECTED
-----------------------	-------	--------	-----------	-----	------	---------	-----------

Water Connection.#	SIZE:	19mmØ	MATERIAL:	COPPER	INV.	651.29m	CONNECTED
--------------------	-------	-------	-----------	--------	------	---------	-----------

Storm Connection.#	SIZE:	100mmØ	MATERIAL:	PVC	INV.	651.29m	CONNECTED
--------------------	-------	--------	-----------	-----	------	---------	-----------

Cash Receipt No's:	WATER	SANITARY	STORM
--------------------	-------	----------	-------

CURB FROM PROPERTY LINE	5m	PAVEMENT WIDTH	10m
-------------------------	----	----------------	-----

HYDRO	75mm DB2	U/G CONNECTION	✓
-------	----------	----------------	---

TELEPHONE	50mm DB2	U/G CONNECTION	✓
-----------	----------	----------------	---


GAS	42 PROP/P.E.		
-----	--------------	--	--

Information Sheets: REF. DWGS. L&M ENGINEERING LTD. JOB 1432-03

Comments: CS CURB STOP SDW WATER SERVICE U/G HYDRO SERVICE GAS GAS
CO CLEAN OUT STORM SERVICE CABLE SERVICE E ELECTRICAL
SANITARY SERVICE TELECOMMUNICATIONS

THE INFORMATION CONTAINED HEREIN IS FOR INTERNAL USE ONLY.
NOT TO BE RELIED UPON UNLESS CONFIRMED BY THE SITE INSPECTION AND/OR INVESTIGATION

For revised property boundary,
see legal plan EPP139192

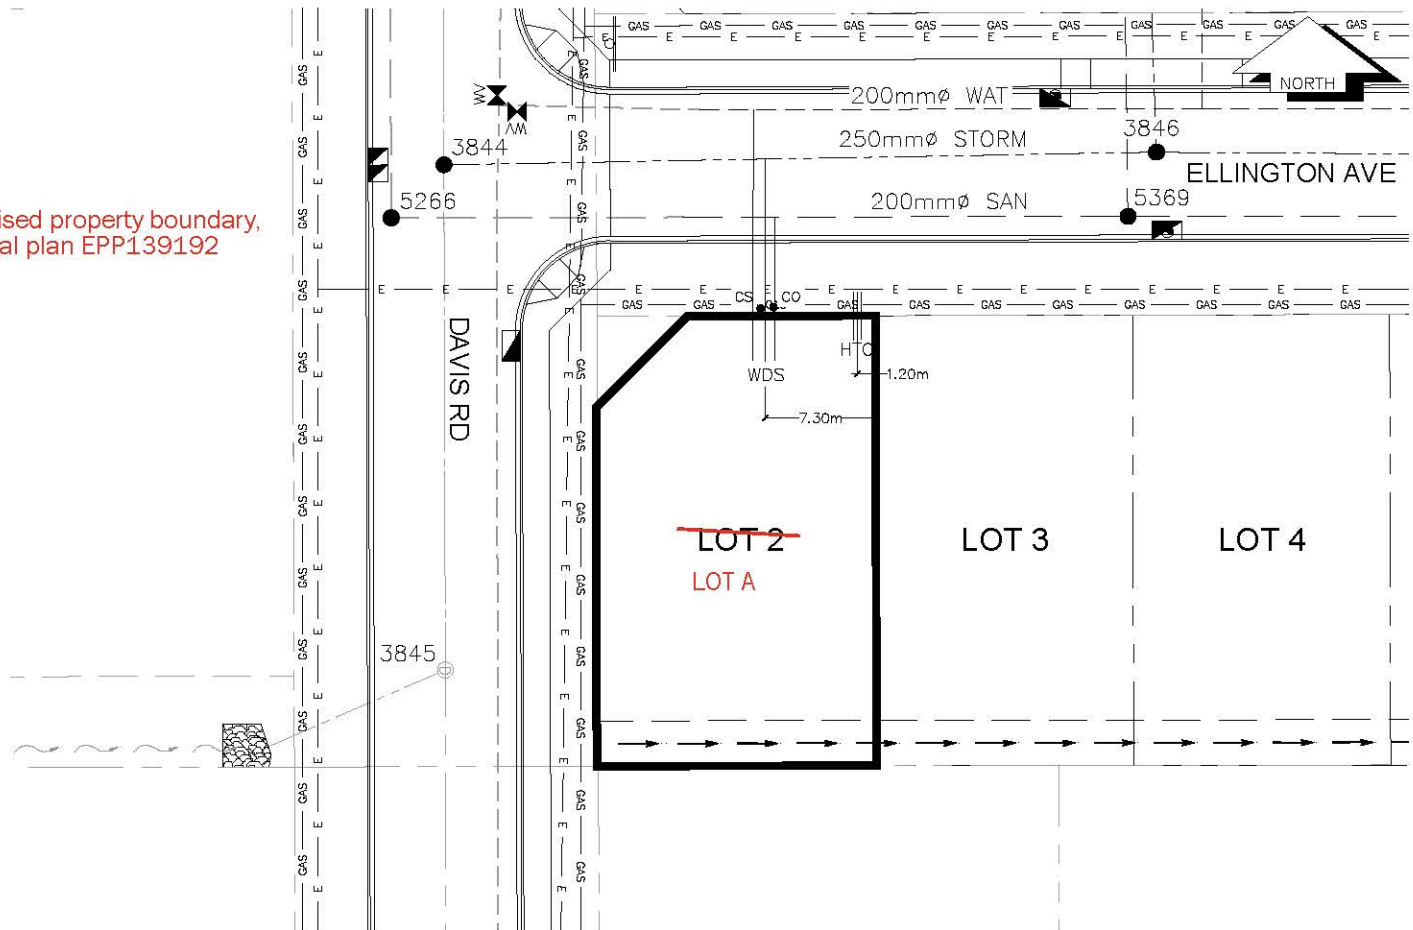

SANITARY, STORM & WATER SERVICE INVERTS	SANITARY	WATER	STORM
1. Distance from San. M.H. <u>5266</u> toward San. M.H. <u>5369</u> to lot service connection point is:	25.37m	N/A	N/A
1a.Distance from Stm. M.H. <u>3844</u> toward Stm. M.H. <u>3846</u> to lot service connection point is:	N/A	N/A	21.39m
2. Main Size at connection point is	200mmØ	200mmØ	250mmØ
3. Invert of main at conn. stub point is	650.32m	650.72m	650.14m
4. Invert at service end is	651.20m	651.30m	651.28m
5. Cover at property line in meters	2.53m	2.54m	2.43m
6. Survey Date: JUNE 2015 Book Ref.:1432-03 By:L&M ENGINEERING LTD.			

SANITARY HISTORY:

DATE INSTALLED: JUNE 2015

INSTALLED BY: JOE ROBERTS CONSTRUCTION & CONSULTING SERVICE LTD.

WATER HISTORY:

DATE INSTALLED: JUNE 2015

INSTALLED BY: JOE ROBERTS CONSTRUCTION & CONSULTING SERVICE LTD.

STORM HISTORY:

DATE INSTALLED: JUNE 2015

INSTALLED BY: JOE ROBERTS CONSTRUCTION & CONSULTING SERVICE LTD.