



CITY OF
PRINCE GEORGE

City of Prince George HISTORY SHEET

PID:	032-485-786
SD/MU:	SD100610
WO:	

CIVIC ADDRESS: 5563 & 5565 KIDD PLACE

LEGAL DESCRIPTION: LOT_8 D.L.2425

PLAN_EPP133216

SERVICE TYPE	DIAMETER (mm)	MATERIAL	INVERT ELEV AT MAIN (m)	INVERT ELEV AT PROPERTY LINE (m)	INVERT ELEV AT SERVICE END (m)	COVER AT PROPERTY LINE (m)	DISTANCE INTO PROPERTY (m)	INSTALLATION DATE
SANITARY	100	PVC	763.88	763.97	764.06	1.78	3.1	OCTOBER 2022
WATER	19	COPPER	763.02	763.13	763.07	2.70	3.0	AUGUST 2022
STORM	100	PVC	763.46	763.70	763.75	2.05	3.0	OCTOBER 2022

ELECTRICAL / COMMUNICATIONS / GAS

TYPE	PROVIDER	SIZE AND MATERIAL	LOCATION (UNDERGROUND/ OVERHEAD)
ELECTRICAL	BC HYDRO	75mm DB2	UNDERGROUND
COMMUNICATION	TELUS	50mm DB2	UNDERGROUND
COMMUNICATION	SHAW	50mm DB2	UNDERGROUND
GAS	FORTISBC	42 PROP/P.E.	UNDERGROUND


INFORMATION SHEETS: L&M ENGINEERING LIMITED PROJECT NUMBER 1509-09

SURVEY DATE: NOVEMBER 2022

INSTALLED BY: NORTHWEST CONSTRUCTION

COMMENTS:

THE INFORMATION CONTAINED HEREIN IS FOR INTERNAL USE ONLY.
NOT TO BE RELIED UPON UNLESS CONFIRMED BY SITE INVESTIGATION.

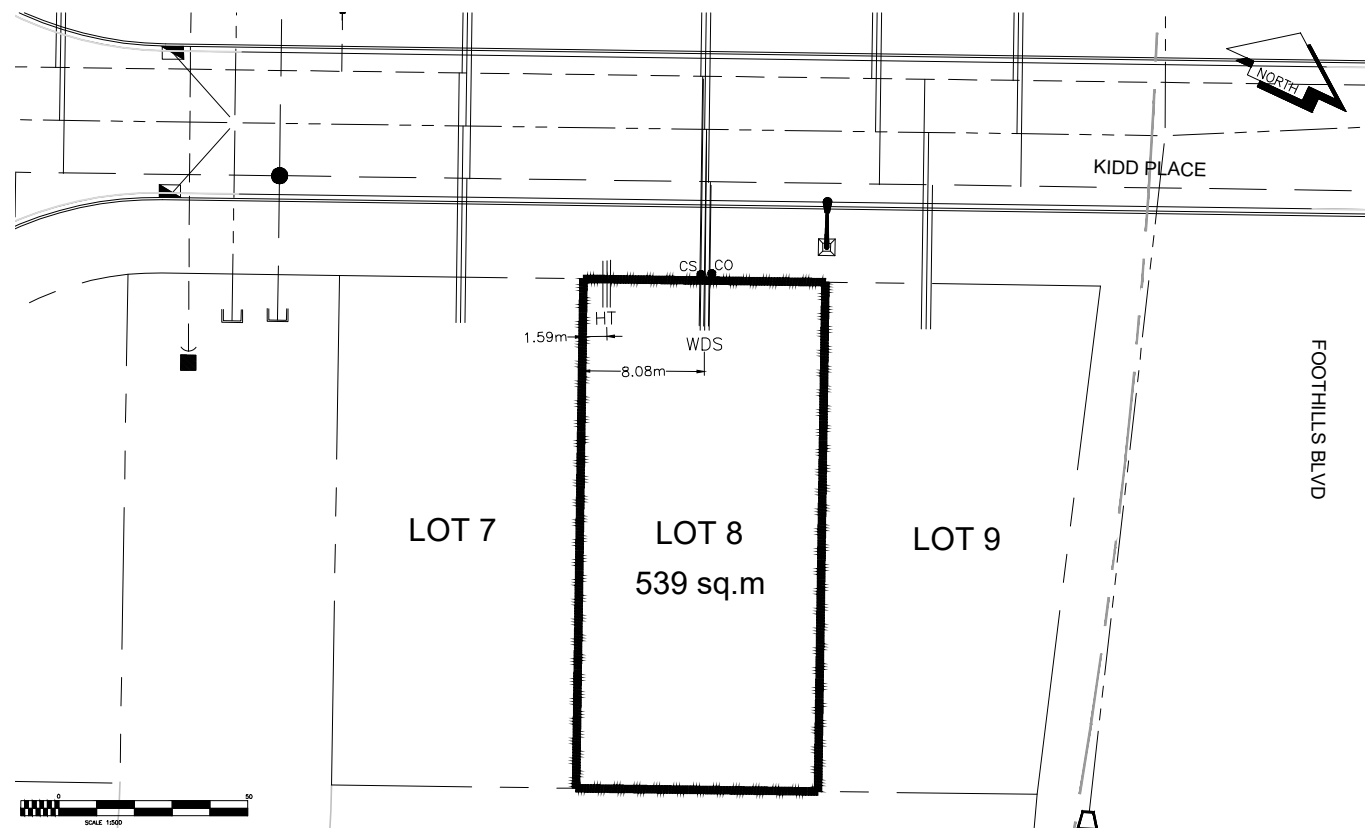

LEGEND:

CS CURB STOP
CO CLEAN OUT

— W — WATER SERVICE
— S — STORM SERVICE
— S — SANITARY SERVICE

— H — HYDRO SERVICE
— T — TELECOMMUNICATIONS

— G — GAS
— E — ELECTRICAL