


City of Prince George HISTORY SHEET

SHEET NUMBER	Nº 1909		Roll Number	
Legal:	(Part of Lot 1 District Lot 343 Cariboo District Plan EPP142588)			
LOT'S	13, 14	BLOCK	280	D.L. 343 PLAN 1268
Address:	1754 REDWOOD STREET			
Sanitary Connection:	# 2844	SIZE 4"	MATERIAL	INV. CONNECTED
Water Connection	# 546	SIZE	MATERIAL	METER CONNECTED
Storm Connection:	#	SIZE	MATERIAL	INV. CONNECTED
Cash Receipt No's:	WATER		SANITARY 39 NON CASH	STORM
CURB FROM PROPERTY LINE			PAVEMENT WIDTH	
B.C. HYDRO	UNDERGROUND CONNECTION			
B.C. TELEPHONE	UNDERGROUND CONNECTION			
INLAND GAS				
Information Sheets:	<div style="border: 1px solid black; padding: 10px; text-align: center;"> <p>The information contained herein is for internal use only. Not to be relied upon unless confirmed by site inspection and/or investigation.</p> </div>			
Comments:				

SITE

PLAN

N.T.S.

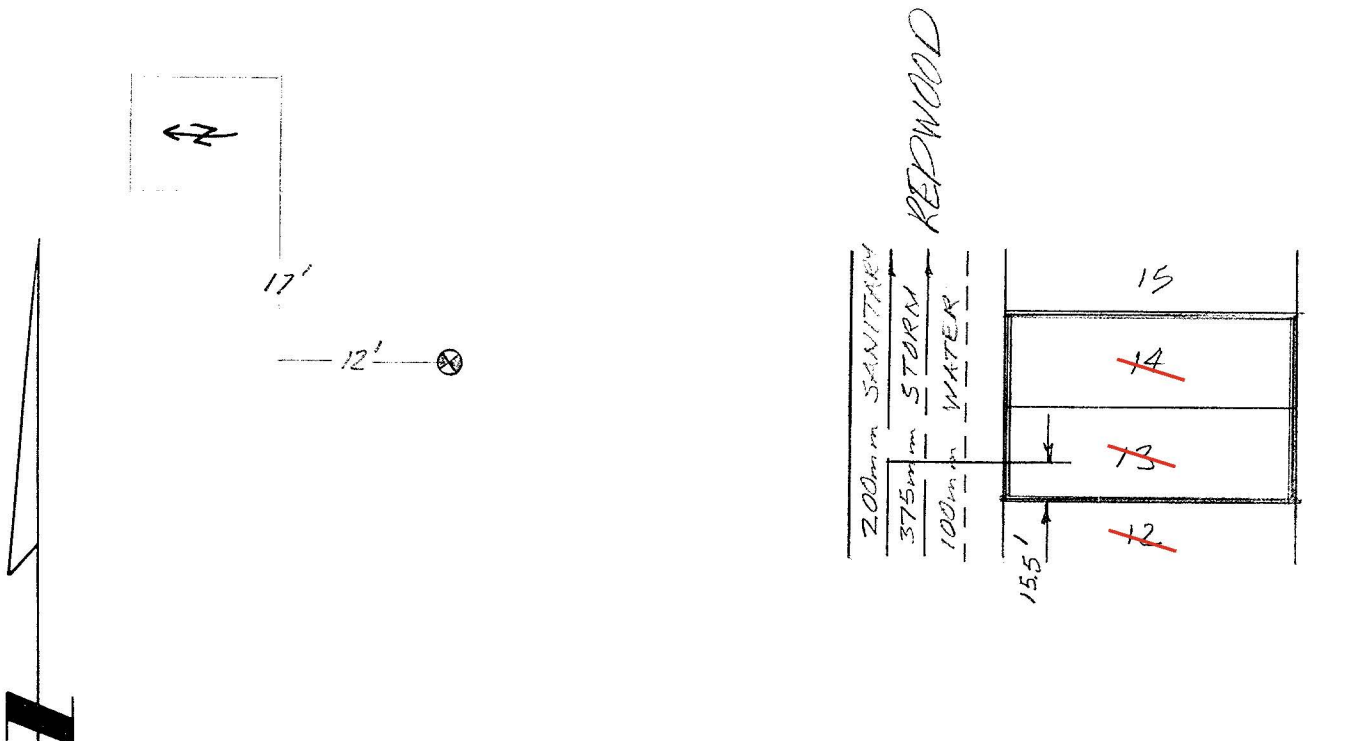

City of Prince George
HISTORY SHEET

9

SHEET NUMBER **Nº 1895** Roll Number

Legal: LOT'S **11, 12** BLOCK **280** D.L. **343** PLAN **1268**
(Part of Lot 1 District Lot 343 Cariboo District Plan EPP142588)

Address: **1786 REDWOOD STREET**

Sanitary Connection: # **2845** SIZE **4"** MATERIAL INV. CONNECTED

Water Connection # **1826** SIZE **1 1/2"** MATERIAL METER CONNECTED

Storm Connection: # SIZE MATERIAL INV. CONNECTED

Cash Receipt No's: WATER SANITARY STORM

CURB FROM PROPERTY LINE PAVEMENT WIDTH

B.C. HYDRO UNDERGROUND CONNECTION

B.C. TELEPHONE UNDERGROUND CONNECTION



INLAND GAS

Information Sheets:

Comments:

The information contained herein is for internal use only. Not to be relied upon unless confirmed by site inspection and/or investigation.

SITE PLAN N.T.S.

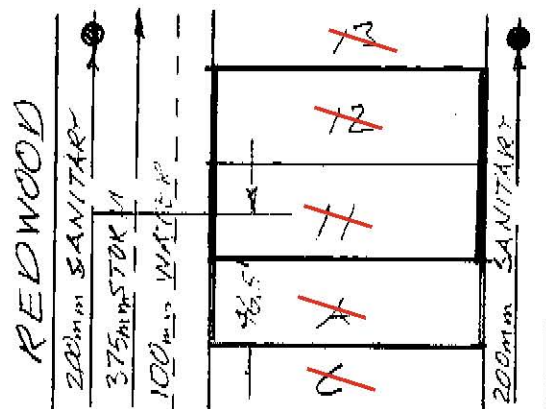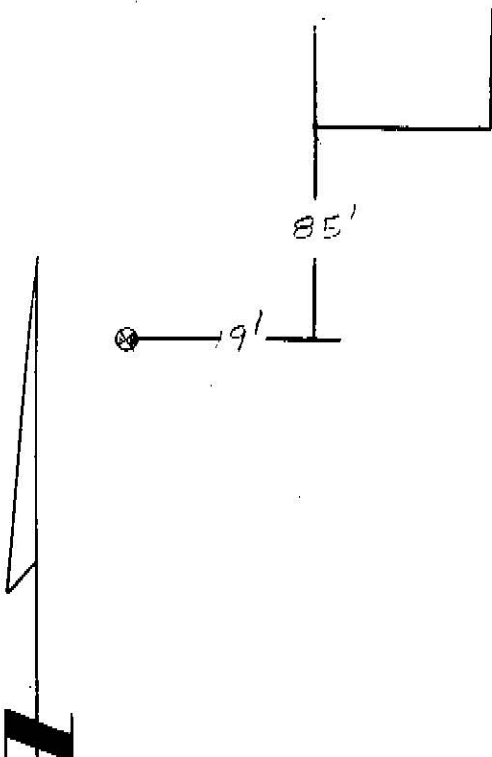

~~010793348~~

D S


City of Prince George HISTORY SHEET

SHEET NUMBER		N ^o 1895		Roll Number	
(Part of Lot 1 District Lot 343 Cariboo District Plan EPP142588)					
Legal:	LOT'S	BLOCK	D.L.	PLAN	
	A	280	343	126 B	
Address: 1794 REDWOOD STREET					
Sanitary Connection:	#	SIZE	MATERIAL	INV.	CONNECTED
Water Connection	#	SIZE	MATERIAL	METER	CONNECTED
Storm Connection:	#	SIZE	MATERIAL	INV.	CONNECTED
Cash Receipt No's:	WATER		SANITARY		STORM
CURB FROM PROPERTY LINE			PAVEMENT WIDTH		
B.C. HYDRO			UNDERGROUND CONNECTION		
B.C. TELEPHONE			UNDERGROUND CONNECTION		
INLAND GAS					
Information Sheets:		<div style="border: 1px solid black; padding: 10px; text-align: center;"> <p>The information contained herein is for internal use only. Not to be relied upon unless confirmed by site inspection and/or investigation.</p> </div>			
Comments:					

SITE

PLAN

N.T.S.

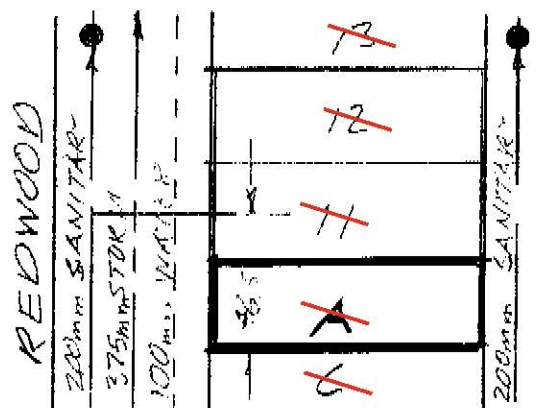

City of Prince George HISTORY SHEET

SHEET NUMBER N^o 1892

Roll Number

(Part of Lot 1 District Lot 343 Cariboo District Plan EPP142588)

Legal: LOT'S ~~19,20~~ BLOCK ~~316~~ D.L. ~~343~~ PLAN ~~1268~~Address: ~~1812 RED WOOD STREET~~

Sanitary Connection: # 1598 SIZE MATERIAL INV. CONNECTED

Water Connection # 695 SIZE 3/4" MATERIAL COPPER METER CONNECTED

Storm Connection: # SIZE MATERIAL INV. CONNECTED

Cash Receipt No's: WATER SANITARY STORM

CURB FROM PROPERTY LINE PAVEMENT WIDTH

B.C. HYDRO UNDERGROUND CONNECTION

B.C. TELEPHONE UNDERGROUND CONNECTION

INLAND GAS

Information Sheets:


Comments:

The information contained herein is
for internal use only. Not to be
relied upon unless confirmed by site
inspection and/or investigation.

SITE

PLAN

N.T.S.

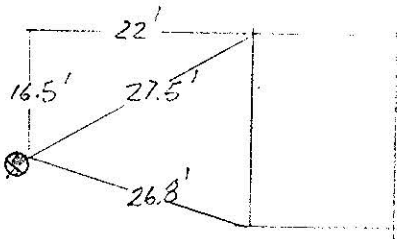

REDWOOD

200mm SANITARY

375mm STORM

100mm WATER

