

City of Prince George HISTORY SHEET

PID 032682158

~~008619522~~

SHEET NUMBER **8658** Roll Number

Legal: LOT'S ~~31~~ ^{LOT 7} BLOCK D.L. 2013 PLAN ~~23117~~ ^{EPP119190}

Address: 8175 PRINCE EDWARD CRES.

Sanitary Connection: # SIZE 4" MATERIAL ~~P.U.C.~~ ^W INV. CONNECTED

Water Connection # SIZE 3/4" MATERIAL COPPER METER CONNECTED

Storm Connection: # SIZE 4" MATERIAL ~~GR~~ ^{GR} PVC INV. CONNECTED

Cash Receipt No's: WATER SANITARY STORM

CURB FROM PROPERTY LINE 16' PAVEMENT WIDTH 34'

B.C. HYDRO 3' UNDERGROUND CONNECTION ☒

B.C. TELEPHONE 3' UNDERGROUND CONNECTION ☒


INLAND GAS

Information Sheets: 66' R/W

The information contained herein is for internal use only. Not to be relied upon unless confirmed by site inspection and/or investigation.

Comments:

Card No.	Unit	House	Street	Propert...	Service Type	Material Type	Service Size	Meter No.	Location
034092		8175	PRINCE EDWARD CRES	138855	SANITARY	PVC	100MM		1.82M E OF NW COR PL 3.048M N
034093		8175	PRINCE EDWARD CRES	138855	WATER	CU	20MM		1.52M E OF NW COR PL 3.048M N ; FR NW COR BLD 15.3M N 0.5M W

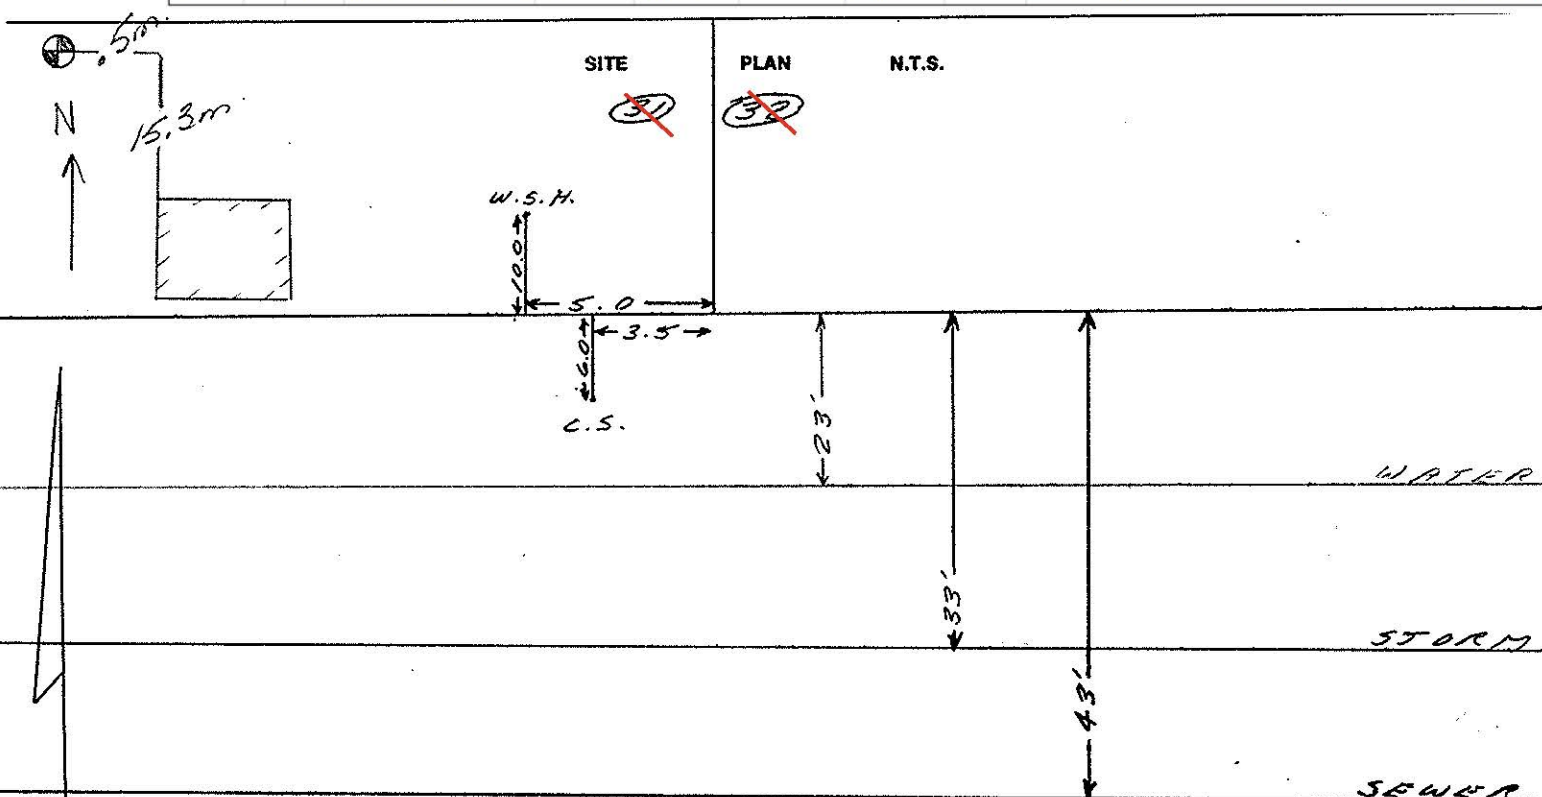

This diagram is incorrect. The street is north of the property, and Lot 32 is west of Lot 31.