

City of Prince George
HISTORY SHEET

032686277 (Lot A)
032686285 (Lot B)

SHEET NUMBER

Roll Number ~~008524645~~

Legal: LOT'S ~~68~~ Lot A and Lot B BLOCK D.L. 1599 PLAN ~~EPP142920~~ ~~13589~~

Address: 7435 EUGENE RD. 7435 Eugene Rd - Lot A
7447 Eugene Rd - Lot B

Sanitary Connection: # 16243 SIZE 100mm MATERIAL INV. CONNECTED

Water Connection # 11890 SIZE 20mm MATERIAL CU. METER CONNECTED

Storm Connection: # SIZE MATERIAL INV. CONNECTED

Cash Receipt No's: WATER 1056 SANITARY STORM

CURB FROM PROPERTY LINE PAVEMENT WIDTH

B.C. HYDRO UNDERGROUND CONNECTION

B.C. TELEPHONE UNDERGROUND CONNECTION




INLAND GAS as shown

Information Sheets:

Comments:

The information contained herein is for internal use only. Not to be relied upon unless confirmed by site inspection and/or investigation.

SITE PLAN N.T.S.

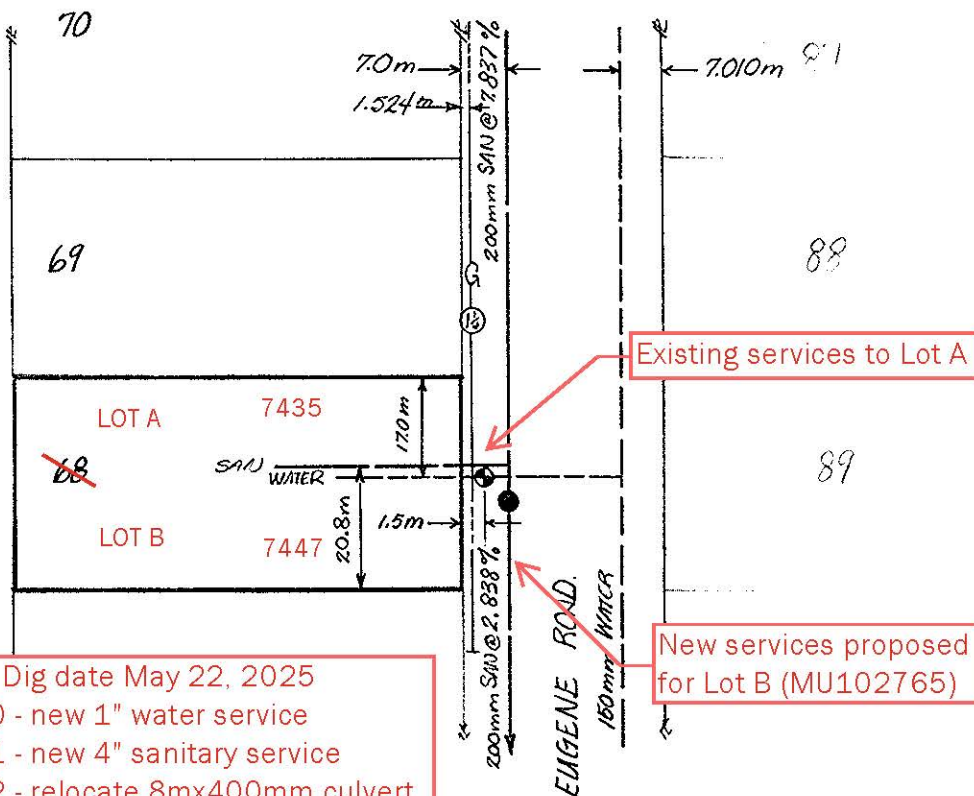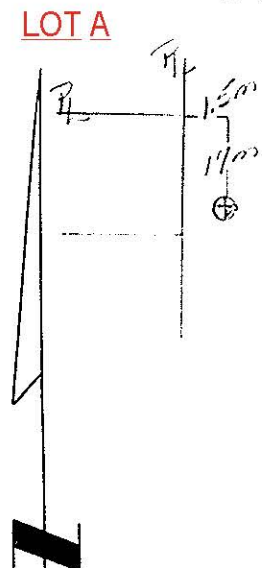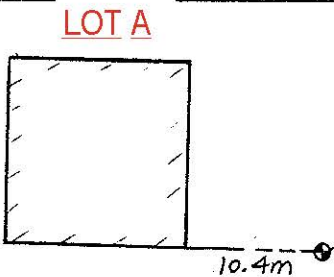

MU102765 - Dig date May 22, 2025
WO 5041020 - new 1" water service
WO 5041021 - new 4" sanitary service
WO 5041022 - relocate 8mx400mm culvert

Existing services to Lot A

New services proposed for Lot B (MU102765)