



City of Prince George History Sheet

PID:	BCS1702
SD/MU:	
WO:	

Civic Address: 1501 Queensway

Legal Description: Lot: CMLPX District Lot: BCS1702 Plan: #####


Service Type	Diameter (mm)	Material	Invert Elev at main (m)	Invert Elev at property line (m)	Invert Elev at service end (m)	Distance into property (m)	Installation Date
Sanitary	200mm	PVC	-	-	-	-	January 1957
Water	150mm	PVC	-	-	-	-	January 1957
Storm	N/A	N/A	-	-	-	-	

Service Connection Location	Sanitary (m)	Storm (m)
200mm Sanitary service connected to San MH 1904	-	
Distance from downstream Stm MH - towards upstream Stm MH	-	

Power	Size	Communications	Size	Cable	Size	Gas	Size
BC Hydro	-	Telus	-	Shaw	-	FortisBC	-
Overhead Service		Overhead Service		Overhead Service			

Installed by:	Survey Date:	-
Comments: Sanitary servicing locate completed Nov 2016. Water location assumed - could not be confirmed.		

NOT TO SCALE The information contained herein is for internal use only.
Not to be relied on unless confirmed by site inspection and/or investigation.

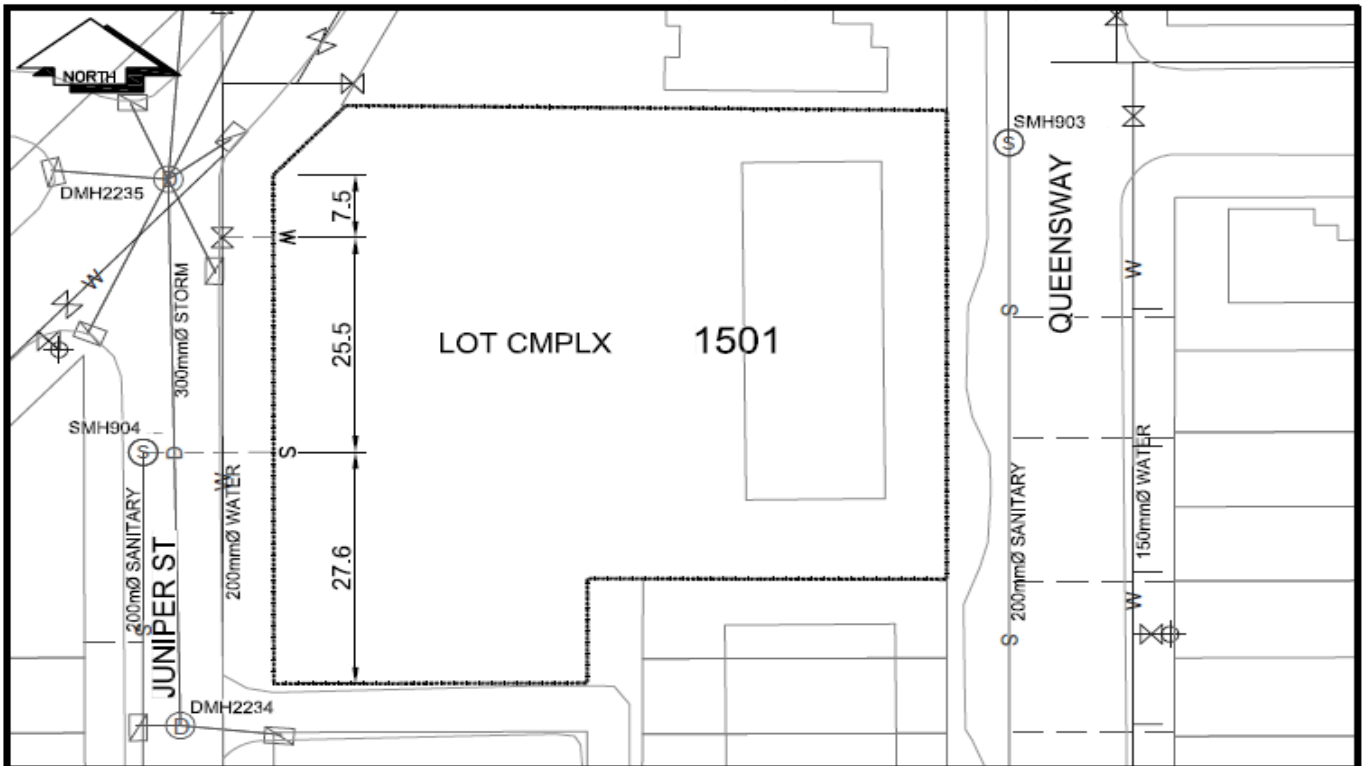

LEGEND:	CS CURB STOP	--- W WATER SERVICE	--- D STORM SERVICE
	CO CLEAN OUT	--- S SANITARY SERVICE	--- G GAS

NOT TO SCALE