

**City of Prince George
HISTORY SHEET**

Installation Date:

PID:

Legal: Lot

Blk:

DL:

PL:

Address:

Fibreoptics

Depth:

Connected:

Sanitary Connection #:

Size:

Material:

Depth:

Connected:

Water Connection #:

Size:

Material:

Depth:

Connected:

Storm Connection #:

Size:

Material:

Depth:

Connected

Cash Receipt Nos:

Water

Sanitary

Storm

Curb from Property Line

Pavement Width

Shaw

BC Hydro

U/G Connection

Telus

U/G Connection


Terasen

Information Sheets:


Comments:

The information contained herein is for internal use only. Not to be relied upon unless confirmed by site inspection and/or investigation.


See attached Eng Drawing

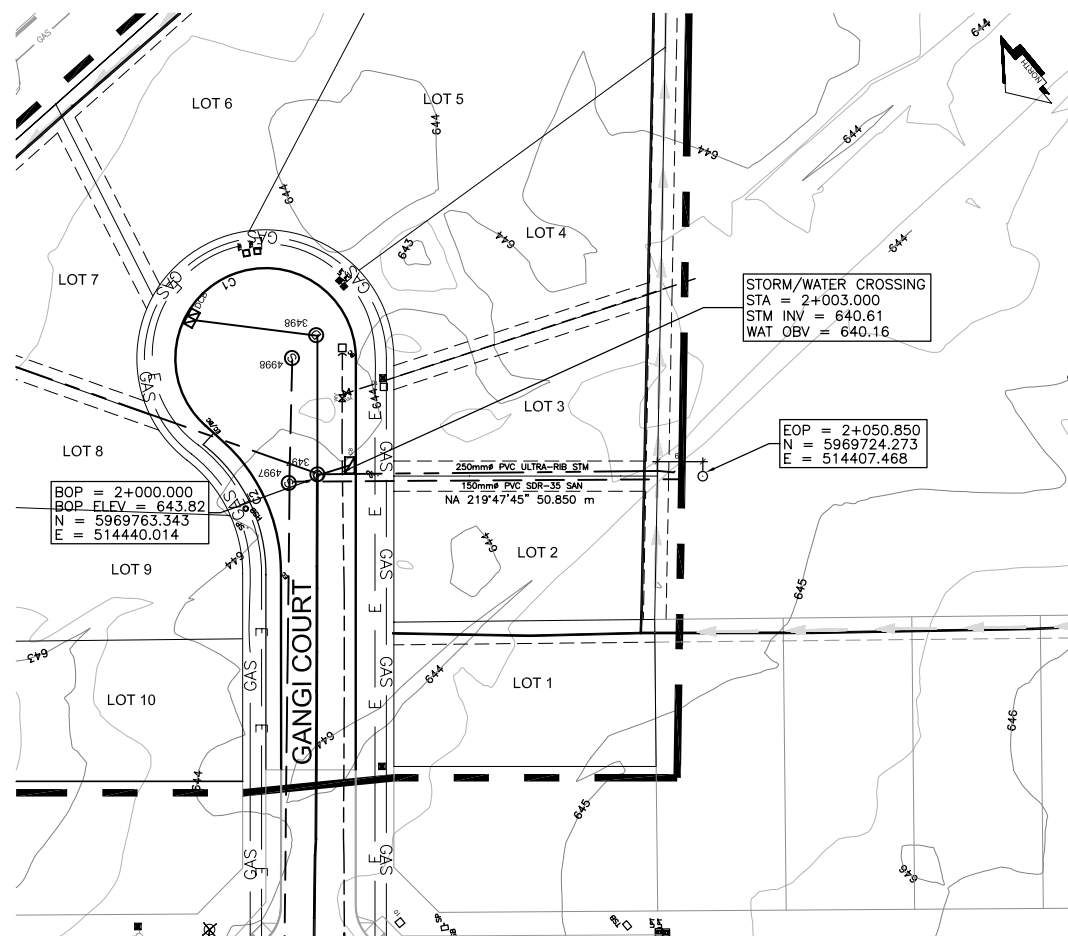


STORM/SANITARY AT LOT 2/3 PROPERTY LINE

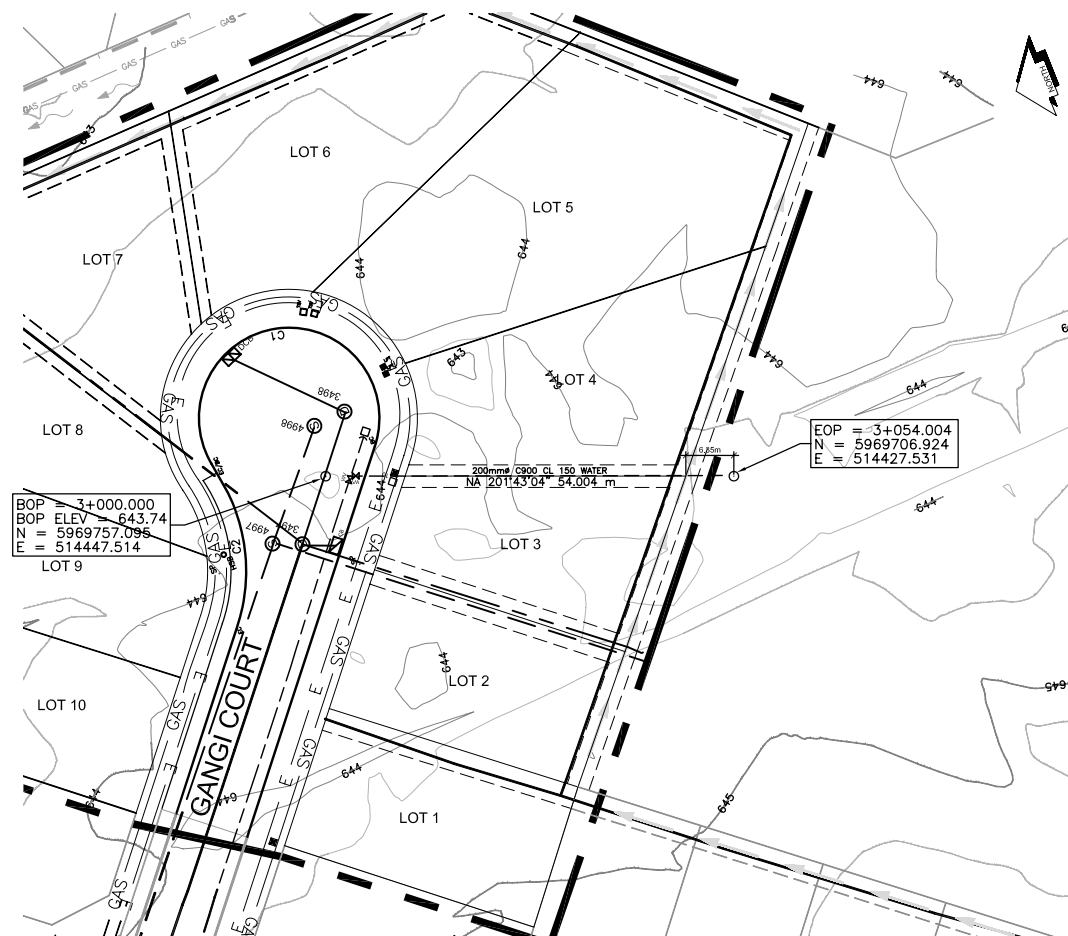

WATER AT LOT 3/4 PROPERTY LINE

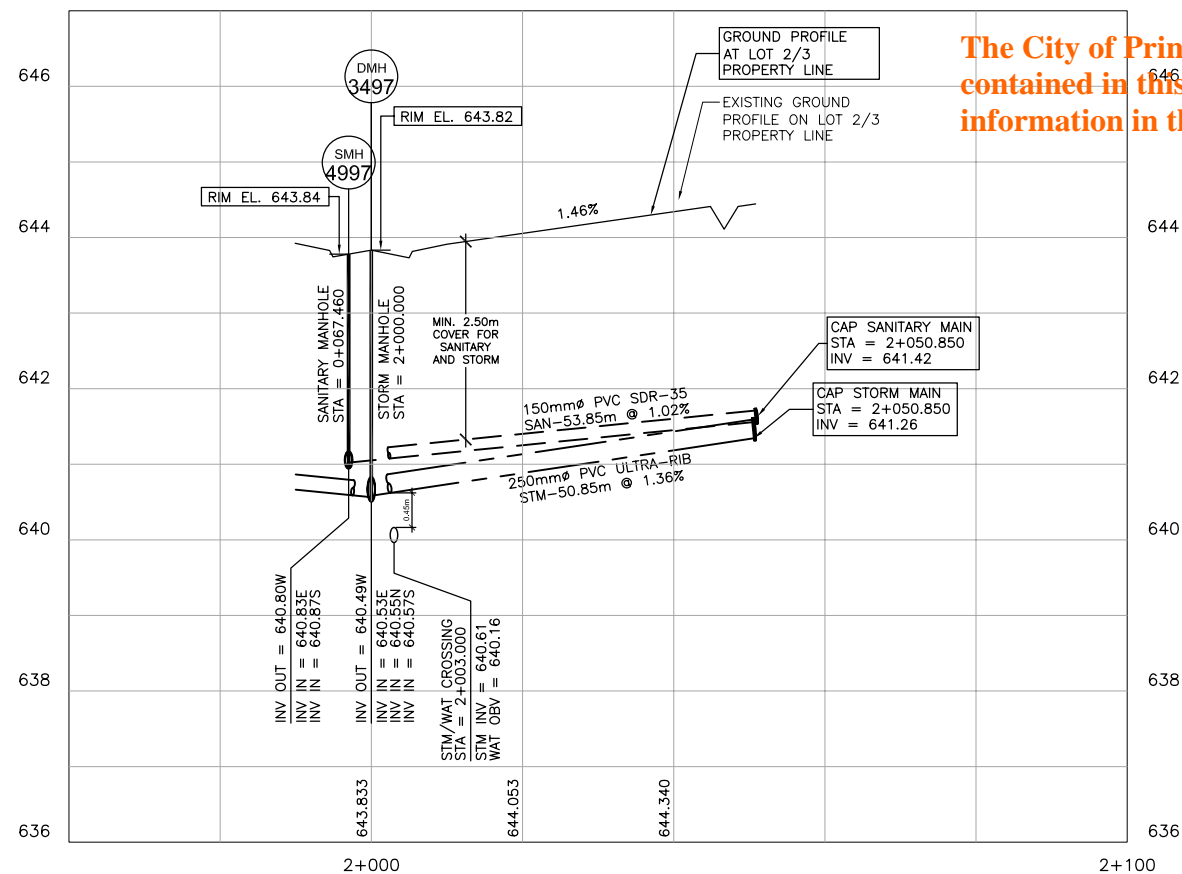

The City of Prince George does not represent or guarantee that information contained in this document is accurate or reliable and any person who relies on the information in this document does so at his own risk

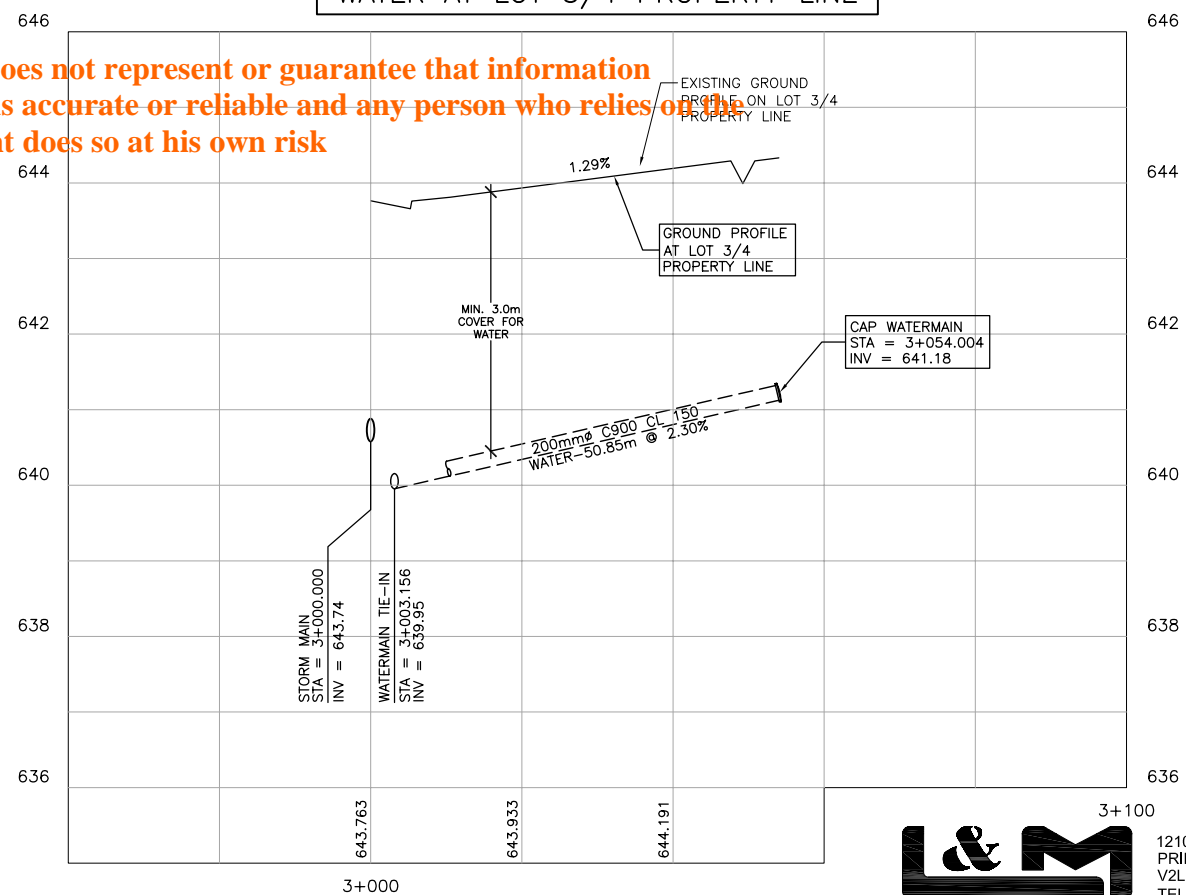

LEGEND

EXISTING

EXISTING WATERMAIN

EXISTING SANITARY MAIN

EXISTING STORM MAIN

EXISTING PROPERTY LINES

○ EX. SANITARY MANHOLE
 ○ EX. STORM MANHOLE
 □ EX. CATCHBASIN
 □ EX. WATER VALVE
 ✕ EX. HYDRANT ASSEMBLY

ASBUILT

ASBUILT WATERMAIN

ASBUILT SANITARY MAIN

ASBUILT STORM MAIN

ASBUILT ELECTRICAL

ASBUILT GAS MAIN E E E E
 GAS GAS GAS GAS GAS

ASBUILT PROPERTY LINES

ASBUILT PROPERTY EASEMENT & DRAINAGE

○ ASBUILT SANITARY MANHOLE
 ○ ASBUILT STORM MANHOLE
 □ ASBUILT CATCHBASIN
 □ ASBUILT WATER VALVE
 ✕ ASBUILT HYDRANT ASSEMBLY
 □ ASBUILT BLOW-OFF
 (ELEV) ASBUILT PROPERTY LINE ELEVATION
 (ELEV) ASBUILT TOP OF CURB ELEVATION
 ASBUILT GRADE
 ASBUILT WATER, STORM, SANITARY SERVICE
 ○ ASBUILT WATER CURBSTOP
 ○ ASBUILT SANITARY CLEANOUT
 ASBUILT HYDRO, TELEPHONE, CABLE SERVICE
 □ ASBUILT SHAW BOX & PEDESTAL
 □ ASBUILT JUNCTION BOX
 □ ASBUILT SERVICE POLE
 □ ASBUILT SHAW PEDESTAL
 □ ASBUILT BC HYDRO LOW PROFILE TRANSFORMER
 □ ASBUILT TELLUS SERVICE VALVE
 □ ASBUILT BC HYDRO SERVICE BOX

NO.	DATE	REVISION	DR.
3	14DEC2007	ISSUED FOR ASBUILT RECORD	NP
2	25MAY2007	REVISED STORM MAIN GRADE	JPA
1	18MAY2007	REVISED LOT GEOMETRICS	JPA
0	13JAP2007	ISSUED FOR APPROVAL	GP



CITY OF
PRINCE GEORGE
Development Services

DRAWN:	GP
CHECKED:	TAF
ENGINEER:	TAF
SURVEY FILE:	
DRAWING FILE:	103_AB.dwg
CORRESPONDENCE:	CPG
GRID:	
DATE:	01/FEB/2007
SCALES:	HOR. 1:500 VER. 1:50

BRAR HOMES
PRUDENTE ROAD & DAVIS ROAD
SUBDIVISION—PHASE 2 (10 LOTS)
STM/SAN AT LOT 2/3 PL & WATER
AT LOT 3/4 PL U/G WORKS

CONSULTANTS PROJECT No.

1292-02-02

DRAWING No.

AB103

3371

SHEET

1 OF 1

REV. No.

3