



City of Prince George
History Sheet

PID:	BCS892
SD/MU:	
WO:	

Civic Address: 1299 Ospika Blvd

Legal Description: Lot: CMLPX District Lot: 2400 Plan: BCS892


Service Type	Diameter (mm)	Material	Invert Elev at main (m)	Invert Elev at property line (m)	Invert Elev at service end (m)	Distance into property (m)	Installation Date
Sanitary	200mm	PVC	-	-	-	-	-
Water	250mm	PVC	-	-	-	-	-
Storm	200mm	PVC	-	-	-	-	-

Service Connection Location	Sanitary (m)	Storm (m)
Sanitary service connected to San MH 4833	-	
Storm service connected to Stm MH 2741		

Power	Size	Communications	Size	Cable	Size	Gas	Size
BC Hydro	-	Telus	-	Shaw	-	FortisBC	-
Underground Service		Underground Service		Underground Service			

Installed by:	Survey Date:	-
Comments:		

NOT TO SCALE The information contained herein is for internal use only.
Not to be relied on unless confirmed by site inspection and/or investigation.

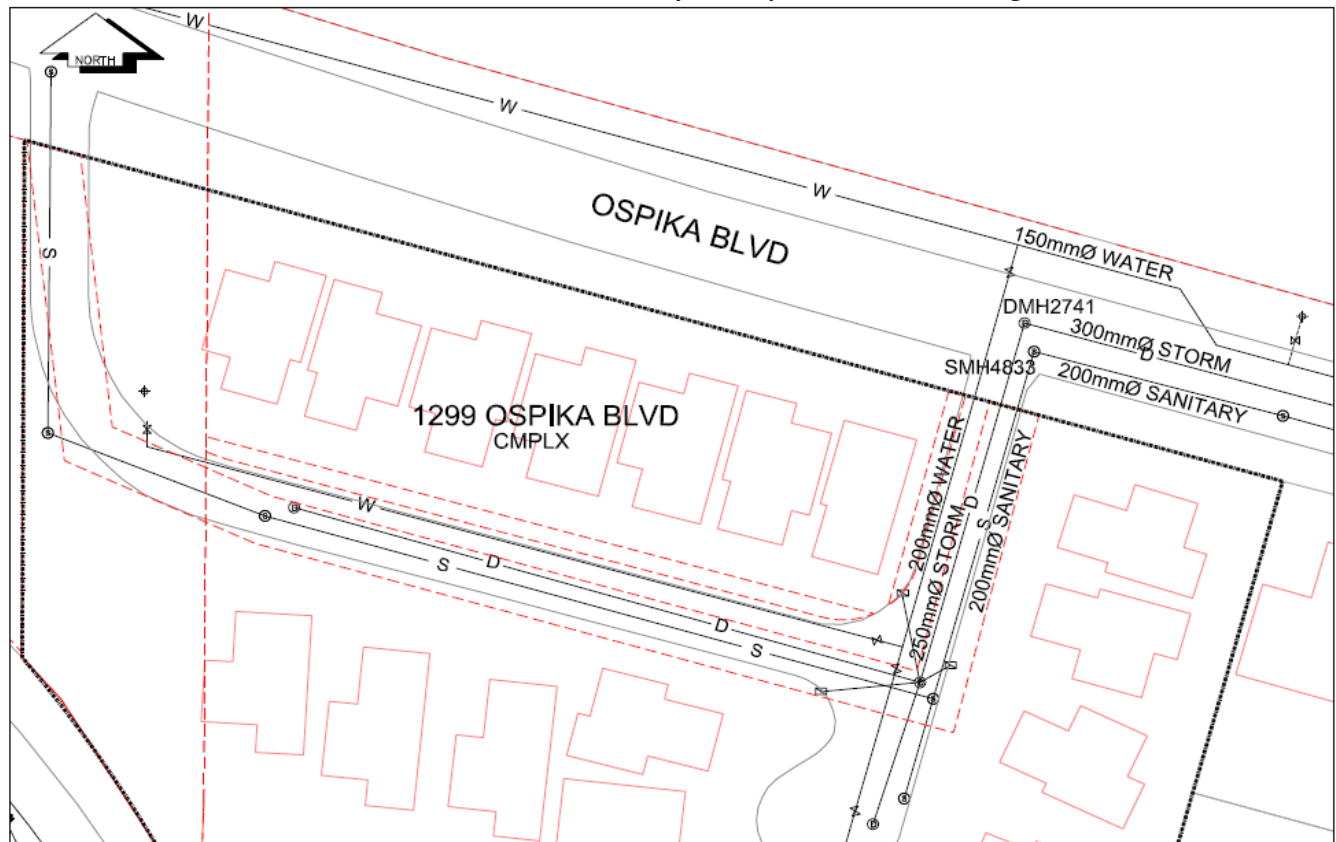

LEGEND:	CS CURB STOP	--- W WATER SERVICE	--- D STORM SERVICE
	CO CLEAN OUT	--- S SANITARY SERVICE	X WATER VALVE

NOT TO SCALE