



City of Prince George History Sheet

PID:	EPS1354
MU:	101326
WO:	76239

Civic Address: 467 Tabor Blvd

Legal Description: Lot: CMLPX District Lot: 2507 Plan: EPS1354


Service Type	Diameter (mm)	Material	Invert Elev at main (m)	Invert Elev at property line (m)	Invert Elev at service end (m)	Distance into property (m)	Installation Date
Sanitary	200mm	PVC	-	-	-	-	August 2012
Water	150mm	PVC	-	-	-	-	August 2012
Storm	250mm	PVC	-	-	-	-	August 2012

Service Connection Location	Sanitary (m)	Storm (m)
200mm Sanitary service connected to San MH 2555	-	
250mm Stor service connected to Stm Mh 382		

Power	Size	Communications	Size	Cable	Size	Gas	Size
BC Hydro	-	Telus	-	Shaw	-	FortisBC	-
Underground Service		Underground Service		Underground Service			

Installed by:	City of Prince George forces	Survey Date:	-
Comments:			

NOT TO SCALE The information contained herein is for internal use only.
Not to be relied on unless confirmed by site inspection and/or investigation.

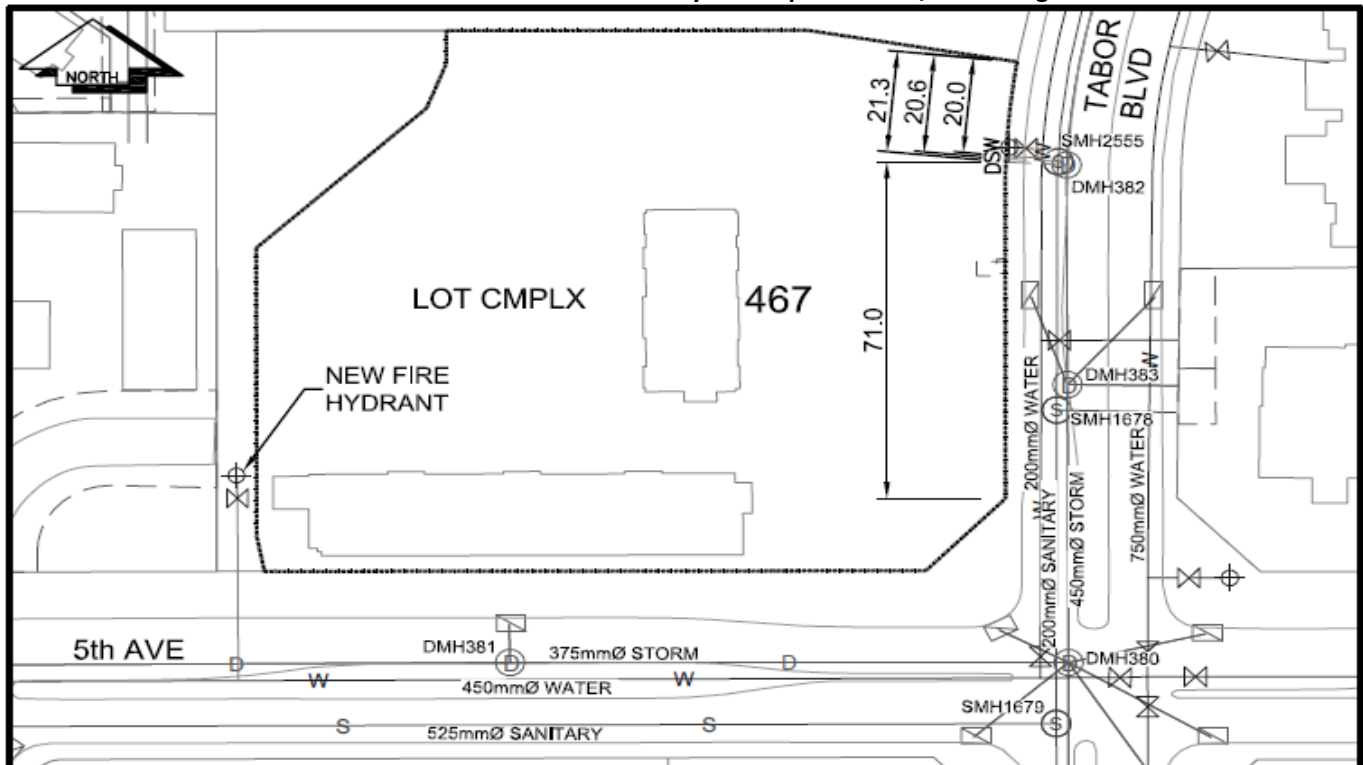

CS CURB STOP	--- W --- WATER SERVICE	--- S --- STORM SERVICE
CO CLEAN OUT	--- S --- SANITARY SERVICE	--- G --- GAS
⊗ WATER VALVE	⊗ FIRE HYDRANT	--- ENCUMBRANCE

NOT TO SCALE