



City of Prince George
History Sheet

PID:	EPS2088
MU:	101387
WO:	71508

Civic Address: 4251 Guest Cres

Legal Description: Lot: CMLPX District Lot: 2611 Plan: EPS2088


Service Type	Diameter (mm)	Material	Invert Elev at main (m)	Invert Elev at property line (m)	Invert Elev at service end (m)	Distance into property (m)	Installation Date
Sanitary	150mm	PVC	-	-	-	-	-
Water	100mm	PVC	-	-	-	-	May 2013
Storm	250mm	PVC	-	-	-	-	-

Service Connection Location				Sanitary (m)	Storm (m)
Distance from downstream San MH	4977	towards upstream San MH	1185	10.30	-
Distance from downstream Stm MH	1974	towards upstream Stm MH	1976	-	13.00

Power	Size	Communications	Size	Cable	Size	Gas	Size
BC Hydro	-	Telus	-	Shaw	-	FortisBC	-
Underground Service		Underground Service		Underground Service			

Installed by:	City of Prince George forces	Survey Date:	-
Comments:			

NOT TO SCALE The information contained herein is for internal use only.
Not to be relied on unless confirmed by site inspection and/or investigation.

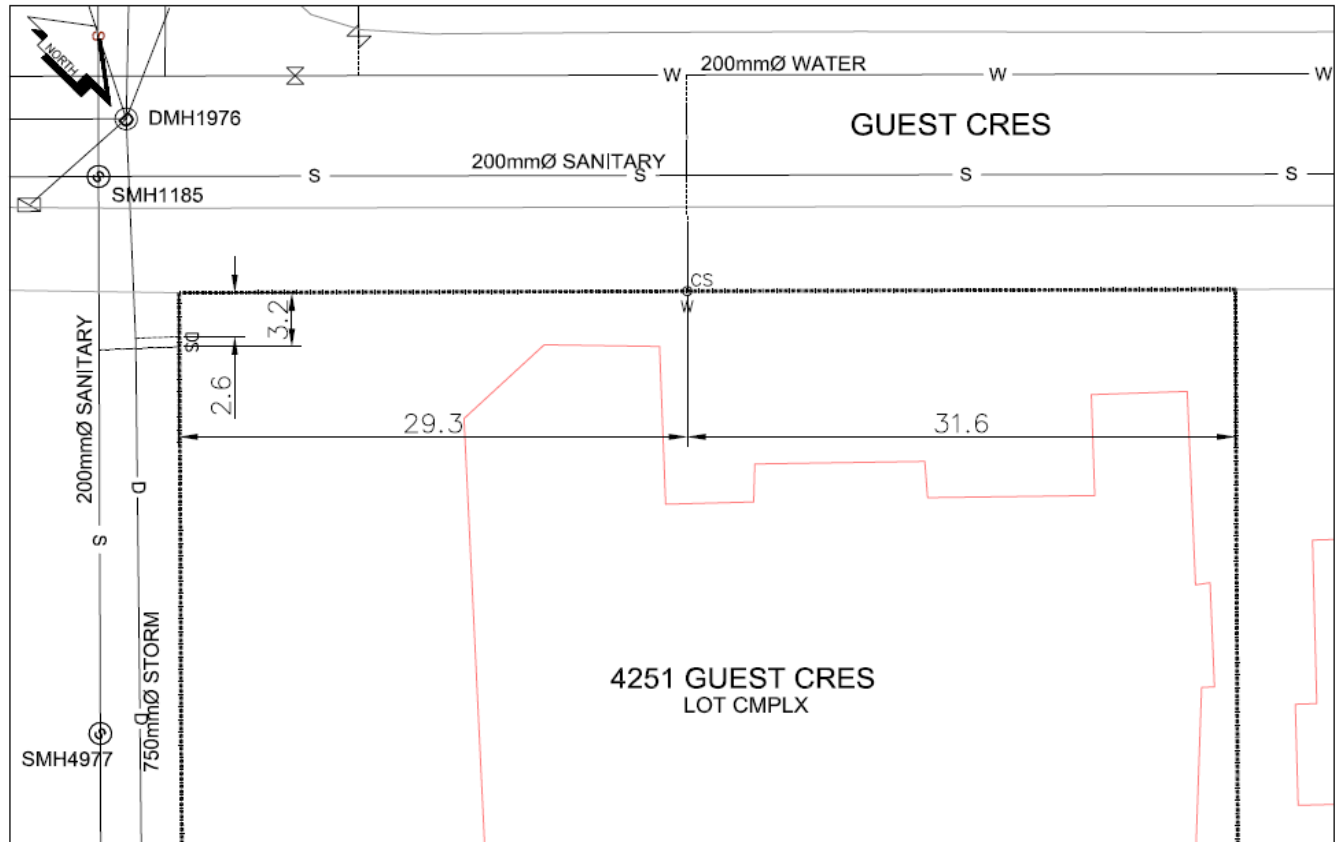

LEGEND:	CS ^o CURB STOP	— — — — — W WATER SERVICE	— — — — — S STORM SERVICE
	CO ^o CLEAN OUT	— — — — — S SANITARY SERVICE	⊗ WATER VALVE

NOT TO SCALE