



# City of Prince George History Sheet

|      |         |
|------|---------|
| PID: | EPS3078 |
| /MU: | 101637  |
| WO:  | 84542   |

Civic Address: 2980 Ellington Ave

Legal Description: Lot: CMLPX STRATA PLAN District Lot: 1433 Plan: EPS3078


| Service Type | Diameter (mm) | Material | Invert Elev at main (m) | Invert Elev at property line (m) | Invert Elev at service end (m) | Distance into property (m) | Installation Date |
|--------------|---------------|----------|-------------------------|----------------------------------|--------------------------------|----------------------------|-------------------|
| Sanitary     | 150mm         | PVC      | 649.69                  | 650.14                           | 650.35                         | 6.00                       | March 2014        |
| Water        | 50mm          | Copper   | -                       | -                                | -                              | 6.00                       | March 2014        |
| Storm        | 250mm         | PVC      | 649.21                  | 649.81                           | 650.16                         | 6.00                       | March 2014        |

| Service Connection Location                     | Sanitary (m) | Storm (m) |
|---|--------------|-----------|
| 150mm Sanitary service connected to San MH 5369 | -            |           |
| 250mm Storm service connected to Stm MH 3846    |              |           |

| Power               | Size | Communications      | Size | Cable               | Size | Gas      | Size |
|---------------------|------|---------------------|------|---------------------|------|----------|------|
| BC Hydro            | -    | Telus               | -    | Shaw                | -    | FortisBC | -    |
| Underground Service |      | Underground Service |      | Underground Service |      |          |      |

|               |                              |              |   |
|---------------|------------------------------|--------------|---|
| Installed by: | City of Prince George Forces | Survey Date: | - |
| Comments:     |                              |              |   |
|               |                              |              |   |
|               |                              |              |   |

**NOT TO SCALE** The information contained herein is for internal use only.  
Not to be relied on unless confirmed by site inspection and/or investigation.

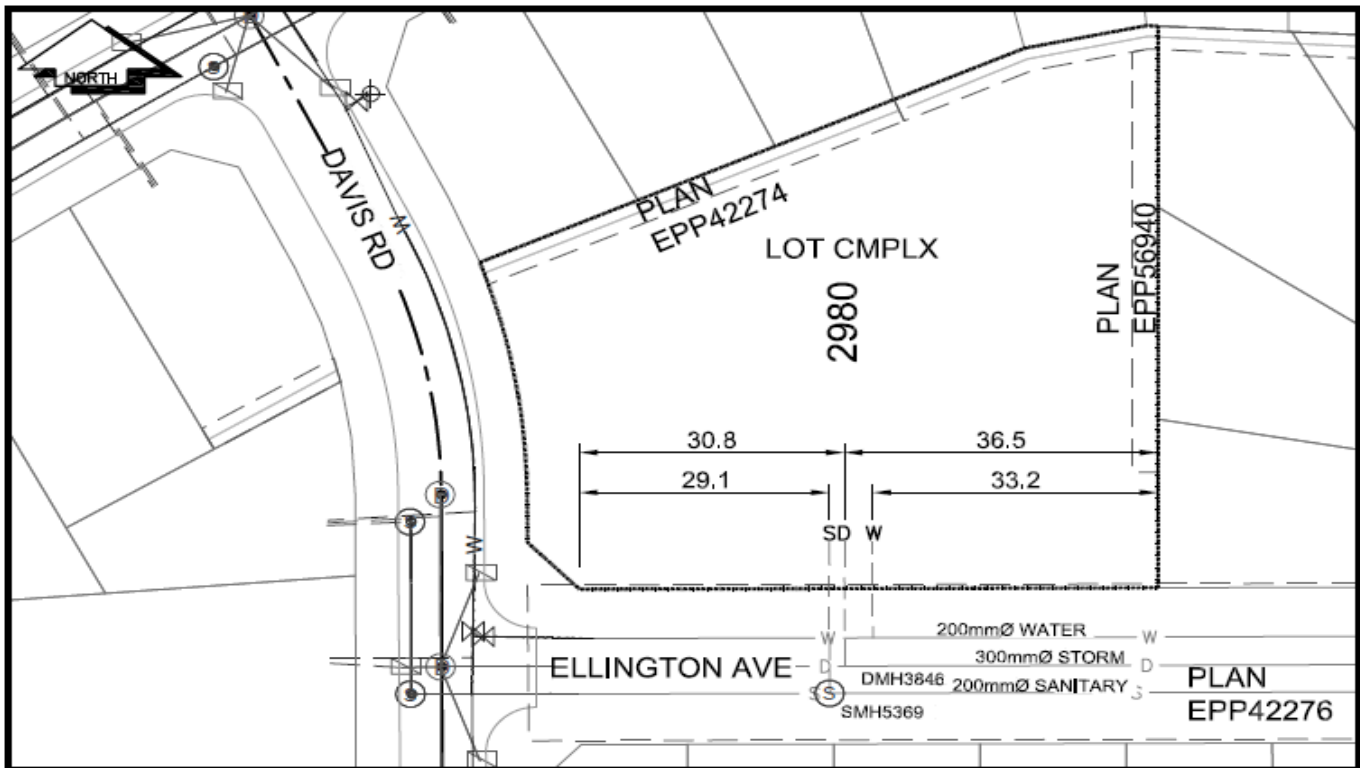

|    |           |     |   |                  |     |   |               |
|----|-----------|-----|---|------------------|-----|---|---------------|
| CS | CURB STOP | --- | W | WATER SERVICE    | --- | D | STORM SERVICE |
| CO | CLEAN OUT | --- | S | SANITARY SERVICE | --- | G | GAS           |

**NOT TO SCALE**