



City of Prince George History Sheet

PID:	EPS3139
SD/MU:	
WO:	

Civic Address: 7692 Creekside Way
7696 Creekside Way

Legal Description: Lot: CMLPX District Lot: 2014 Plan: EPS3139


Service Type	Diameter (mm)	Material	Invert Elev at main (m)	Invert Elev at property line (m)	Invert Depth at service end (m)	Distance into property (m)	Installation Date
Sanitary (7692)	100mm	PVC	582.28	584.19	2.65	-	September 2010
Sanitary (7696)	100mm	PVC	582.29	584.25	2.65	-	September 2010
Water (7692)	20mm	Copper	583.72	583.71	3.13	-	September 2010
Water (7696)	20mm	Copper	583.70	583.84	3.06	-	September 2010
Storm (7692)	100mm	PVC	582.52	58.21	2.63	-	September 2010
Storm (7696)	100mm	PVC	582.42	584.25	2.65	-	September 2010

Service Connection Location				Sanitary (m)	Storm (m)
Distance from downstream San MH	5141	towards upstream San MH	5142	19.58	
(7992) - 100mm Sanitary service connected to San MH 5142					
Distance from downstream Stm MH	3661	towards upstream Stm MH	3662		56.59
(7696) - 100mm Storm service connected to Stm MH 3662					

Power	Size	Communications	Size	Cable	Size	Gas	Size
BC Hydro	75mm DB2	Telus	50mm DB2	Shaw	-	FortisBC	42 PROP/P.E.
Underground Service		Underground Service		Underground Service			

Installed by:	Fortwood Homes Ltd.	Survey Date:	-
Comments:			

NOT TO SCALE The information contained herein is for internal use only.
Not to be relied on unless confirmed by site inspection and/or investigation.

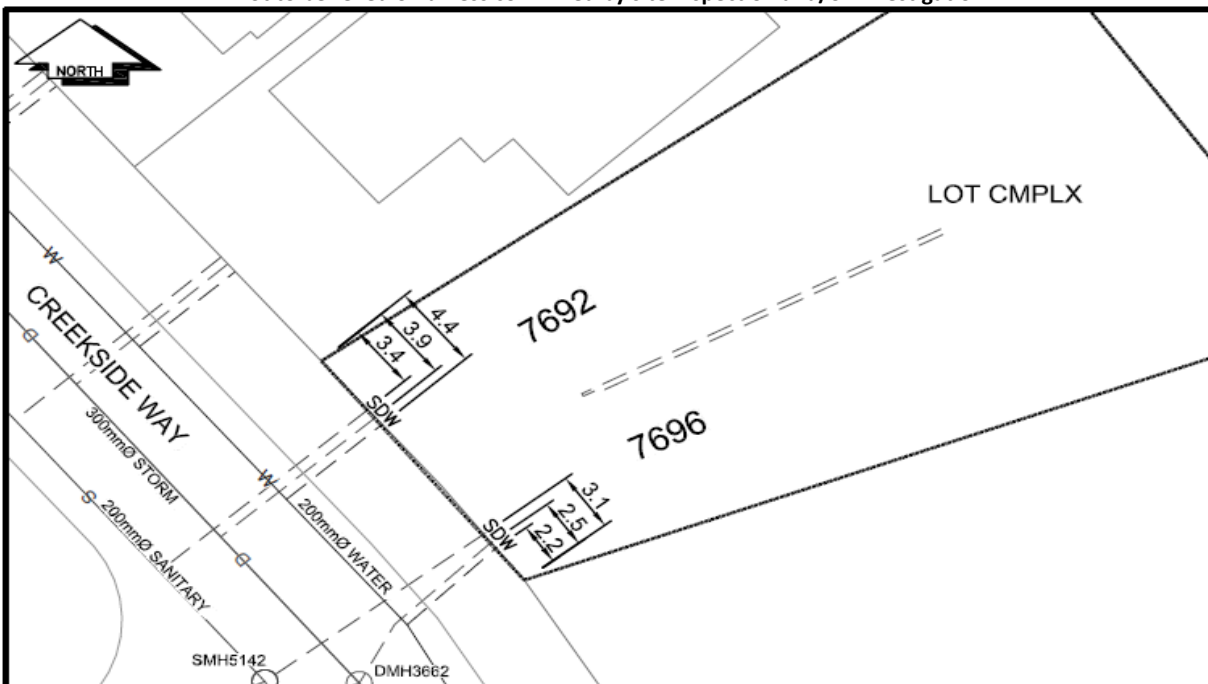

CS	CURB STOP	---	WATER SERVICE	---	STORM SERVICE
CO	CLEAN OUT	---	SANITARY SERVICE	---	GAS
WV	WATER VALVE	---	FIRE HYDRANT	---	ENCUMBRANCE

NOT TO SCALE