



City of Prince George History Sheet

PID:	EPS3168
MU:	101602
WO:	82931/82932

Civic Address: 140 Quebec St

Legal Description: Lot: CMLPX District Lot: 343 Plan: EPS3168


Service Type	Diameter	Material	Invert Elev at main	Invert Elev at property line	Invert Elev service end	Distance into property	Installation Date
Sanitary	150mm	PVC	568.55	568.60	568.67	6.95	August 2015
Water	150mm	PVC	-	-	567.97	-	August 2015
Storm	150mm	PVC	569.70	569.80	569.80	-	August 2015

Service Connection Location	Sanitary	Storm
150mm Sanitary service connected to new San MH in laneway	-	
150Mmm Storm service connected to new Stm MH in Quebec St		-

Power	Size	Communications	Size	Cable	Size	Gas	Size
BC Hydro	-	Telus	-	Shaw	-	FortisBC	-
Underground Service		Underground Service		Underground Service			

Installed by:	City of Prince George forces	Survey Date:	
Comments:	New 150mm water service installed in same trench as disconnected 20mm water service		

NOT TO SCALE The information contained herein is for internal use only.
Not to be relied on unless confirmed by site inspection and/or investigation.

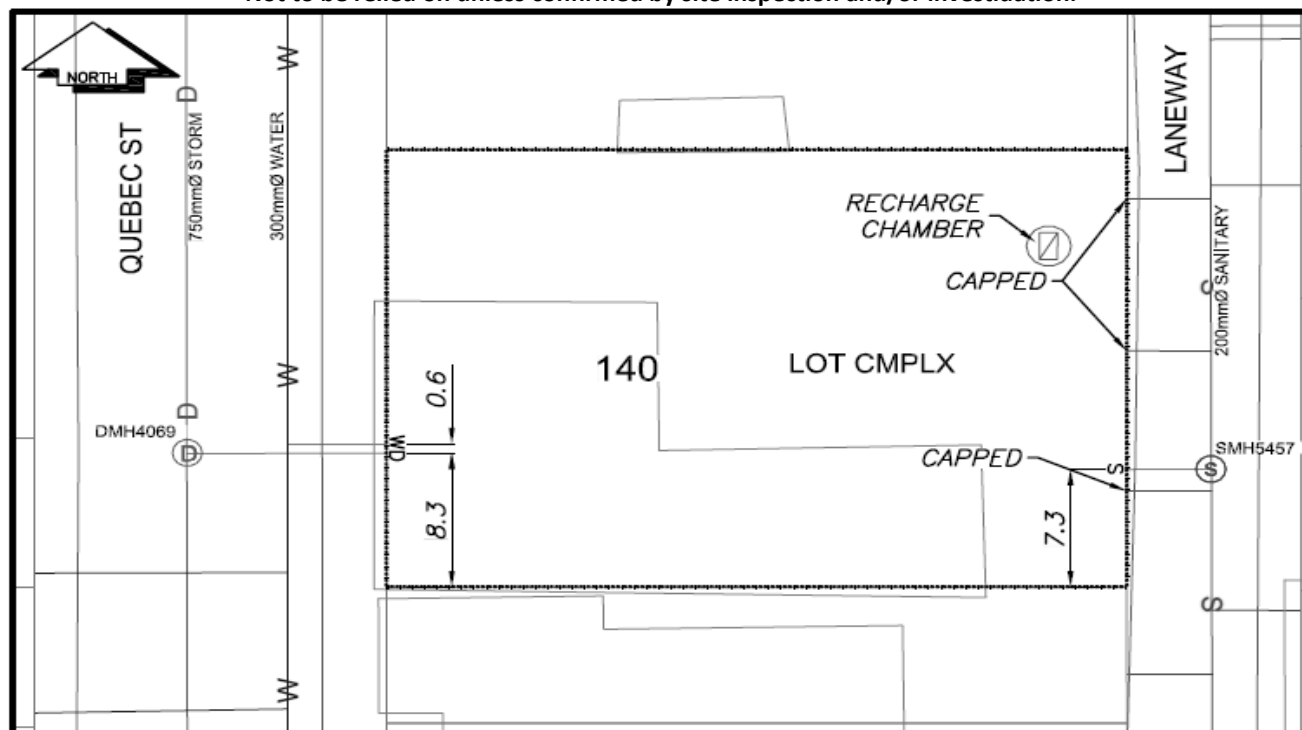

CS ^o CURB STOP	— W — WATER SERVICE	— S — STORM SERVICE
CO ^o CLEAN OUT	- - - S - SANITARY SERVICE	— G — GAS
⊗ WATER VALVE	⊗ FIRE HYDRANT	- - - - ENCUMBRANCE

NOT TO SCALE