



City of Prince George History Sheet

PID:	EPS3812
MU:	101768
WO:	89109/ 89110

Civic Address: 1076 Johnson St
1078 Johnson st

Legal Description: Lot: CMLPX District Lot: 1429 Plan: EPS3812


Service Type	Diameter (mm)	Material	Invert Elev at main (m)	Invert Elev at property line (m)	Invert Elev at service end (m)	Distance into property (m)	Installation Date
Sanitary (1076)	100mm	PVC	-	-	-	-	August 2016
Sanitary (1078)	100mm	AC	-	-	-	-	January 1960
Water (1076)	20mm	Copper	-	-	-	-	Aug 2016
Water (1078)	20mm	Copper	-	-	-	-	January 1960
Storm	N/A	N/A	-	-	-	-	

Service Connection Location				Sanitary (m)	Storm (m)
Distance from downstream San MH	3056	towards upstream San MH	3060	82.74	
Distance from downstream San MH	3056	towards upstream San MH	3060	86.74	
Distance from downstream Stm MH	-	towards upstream Stm MH	-		
Distance from downstream Stm MH	-	towards upstream Stm MH	-		

Power	Size	Communications	Size	Cable	Size	Gas	Size
BC Hydro	-	Telus	-	Shaw	-	FortisBC	-
Overhead Service		Overhead Service		Overhead Service			

Installed by:	City of Prince George forces	Survey Date:	-
Comments:			

NOT TO SCALE The information contained herein is for internal use only.
Not to be relied on unless confirmed by site inspection and/or investigation.

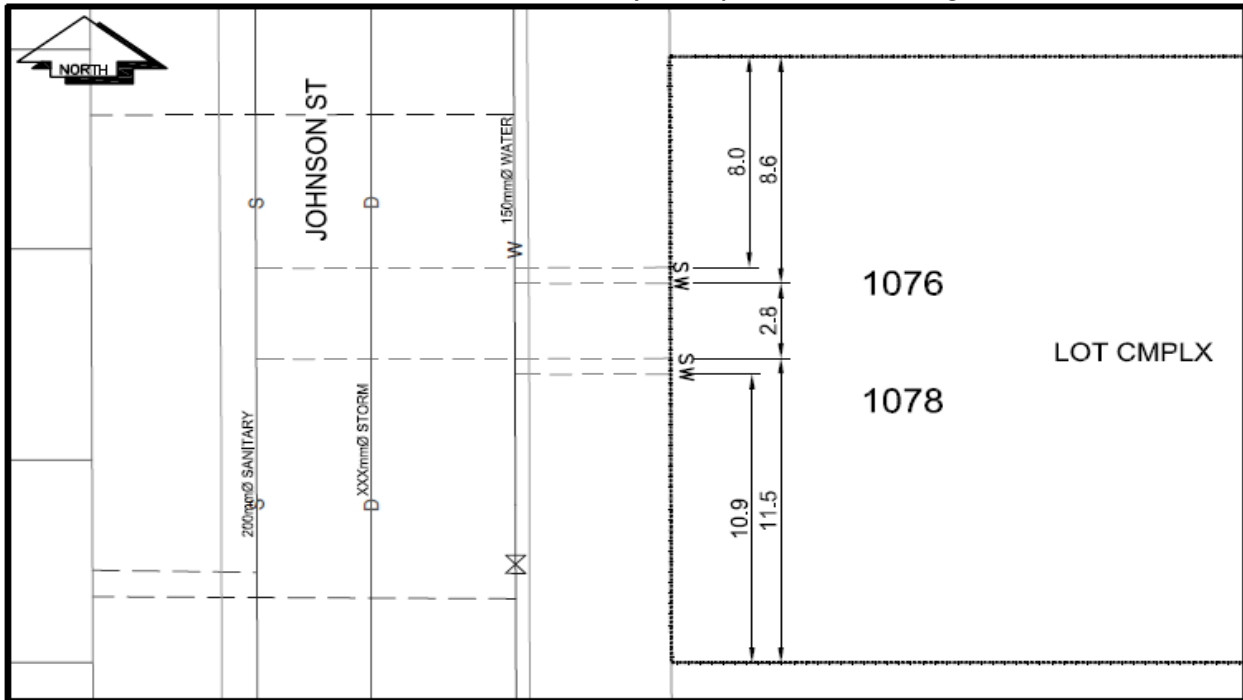

LEGEND:	CS CURB STOP	--- W WATER SERVICE	--- S SANITARY SERVICE	--- D STORM SERVICE	--- G GAS
	CO CLEAN OUT				

NOT TO SCALE