



City of Prince George History Sheet

PID:	030006783
	030006791
SD/MU:	
WO:	

Civic Address: 7728, 7736 Creekside Way

Legal Description: Lot: SL 1 & SL 2 District Lot: 2014 Plan: EPS3905


Service Type	Diameter (mm)	Material	Invert Elev at main (m)	Invert Elev at property line (m)	Invert Depth at service end (m)	Distance into property (m)	Installation Date
Sanitary (S1)	100mm	PVC	582.28	584.47	2.58	-	September 2010
Sanitary (S2)	100mm	PVC	582.29	584.59	2.50	-	September 2010
Water (W1)	20mm	Copper	583.72	584.06	3.00	-	September 2010
Water (W2)	20mm	Copper	583.70	584.08	3.00	-	September 2010
Storm (D1)	100mm	PVC	582.52	584.47	2.58	-	September 2010
Storm (D2_)	100mm	PVC	582.42	584.66	2.43	-	September 2010

Service Connection Location				Sanitary (m)	Storm (m)
Distance from downstream San MH	-	towards upstream San MH	-	-	
Distance from downstream Stm MH	-	towards upstream Stm MH	-		

Power	Size	Communications	Size	Cable	Size	Gas	Size
BC Hydro	-	Telus	-	Shaw	-	FortisBC	-
Underground Service		Underground Service		Underground Service			

Installed by:	Fortwood Homes Ltd.	Survey Date:	-
Comments:			

NOT TO SCALE The information contained herein is for internal use only.
Not to be relied on unless confirmed by site inspection and/or investigation.

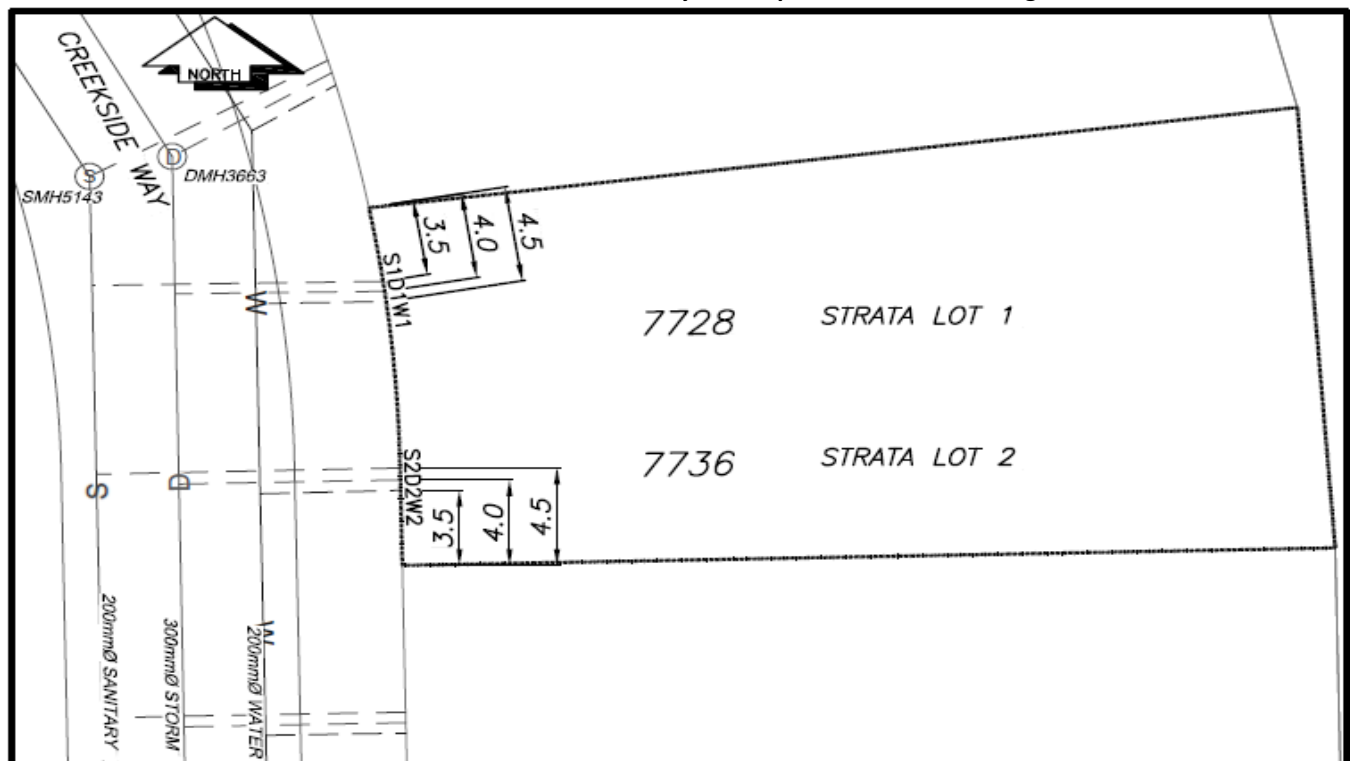

CS ^o CURB STOP	---W--- WATER SERVICE	---D--- STORM SERVICE
CO ^o CLEAN OUT	---S--- SANITARY SERVICE	---G--- GAS
⊗ WATER VALVE	⊗ FIRE HYDRANT	--- --- ENCUMBRANCE

NOT TO SCALE