



City of Prince George History Sheet

PID:	
SD/MU:	
WO:	

Civic Address: 7678, 7683 Stillwater Cres

Legal Description: Lot: SL 1 District Lot: 2014 Strata Plan: EPS4369 PID: 030184835 - 7679 Stillwater Cres
Lot: SL 2 District Lot: 2014 Strata Plan: EPS4369 PID: 030184843 - 7683 Stillwater Cres

Service Type	Diameter (mm)	Material	Invert Elev at main (m)	Invert Elev at property line (m)	Invert Depth at service end (m)	Distance into property (m)	Installation Date
Sanitary - SL1	100mm	PVC	582.28	584.29	2.27	-	October 2009
Water - SL1	20mm	Copper	583.72	583.72	2.89	-	October 2009
Storm - SL1	100mm	PVC	582.52	584.05	2.51	-	October 2009
Sanitary - SL2	100mm	PVC	584.32	584.53	2.13	-	October 2009
Water - SL2	20mm	Copper	583.64	584.13	2.53	-	October 2009
Storm - SL2	100mm	PVC	584.03	584.53	2.13	-	October 2009


Service Connection Location				Sanitary (m)	Storm (m)
Distance from downstream San MH	5178	towards upstream San MH	5147	54.51	
Distance from downstream San MH	5148	towards upstream San MH	5147	61.90	
Distance from downstream Stm MH	3668	towards upstream Stm MH	3667		52.11
Distance from downstream Stm MH	3668	towards upstream Stm MH	3667		59.44

Power	Size	Communications	Size	Cable	Size	Gas	Size
BC Hydro	-	Telus	-	Shaw	-	FortisBC	-
Underground Service		Underground Service		Underground Service			

Installed by: Fortwood Homes Ltd Survey Date: -

Comments:

NOT TO SCALE The information contained herein is for internal use only.
Not to be relied on unless confirmed by site inspection and/or investigation.

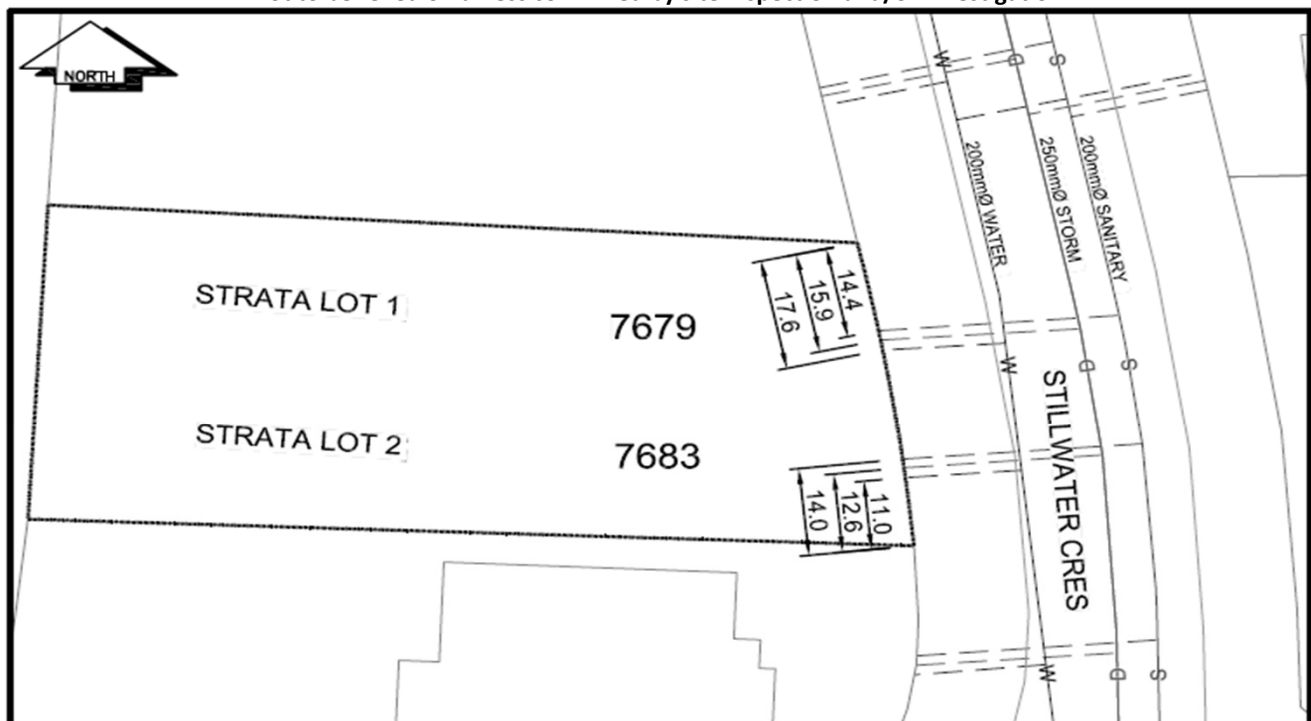

CS ^o CURB STOP	--- WATER SERVICE	--- STORM SERVICE
CO ^o CLEAN OUT	--- SANITARY SERVICE	--- GAS
⊗ WATER VALVE	⊗ FIRE HYDRANT	--- ENCUMBRANCE

NOT TO SCALE