



City of Prince George History Sheet

PID:	EPS4370
MU:	101821
WO:	92273 - 92279

Civic Address: 6798 Westgate Ave

Legal Description: Lot: SL 1 - SL36 District Lot: 1600 Plan: EPS4370 & District Lot: 2003


Service Type	Diameter (mm)	Material	Invert Elev at main (m)	Invert Elev at property line (m)	Invert Elev at service end (m)	Distance into property (m)	Installation Date
Sanitary	200mm	PVC	730.00	-	730.27	1.80	December 2016
Water	200mm	PVC	-	-	729.54	3.00	December 2016
Storm	300mm	PVC	729.90	-	730.40	0.30	December 2016

Service Connection Location	Sanitary (m)	Storm (m)
200mm sanitary service connected to San MH4221	-	
300mm Storm service connected to DMH on Westgate Ave		

Power	Size	Communications	Size	Cable	Size	Gas	Size
BC Hydro	-	Telus	-	Shaw	-	FortisBC	-
Underground Service		Underground Service		Underground Service			

Installed by:	City of Prince George forces	Survey Date:	-
Comments:			

NOT TO SCALE The information contained herein is for internal use only.
Not to be relied on unless confirmed by site inspection and/or investigation.

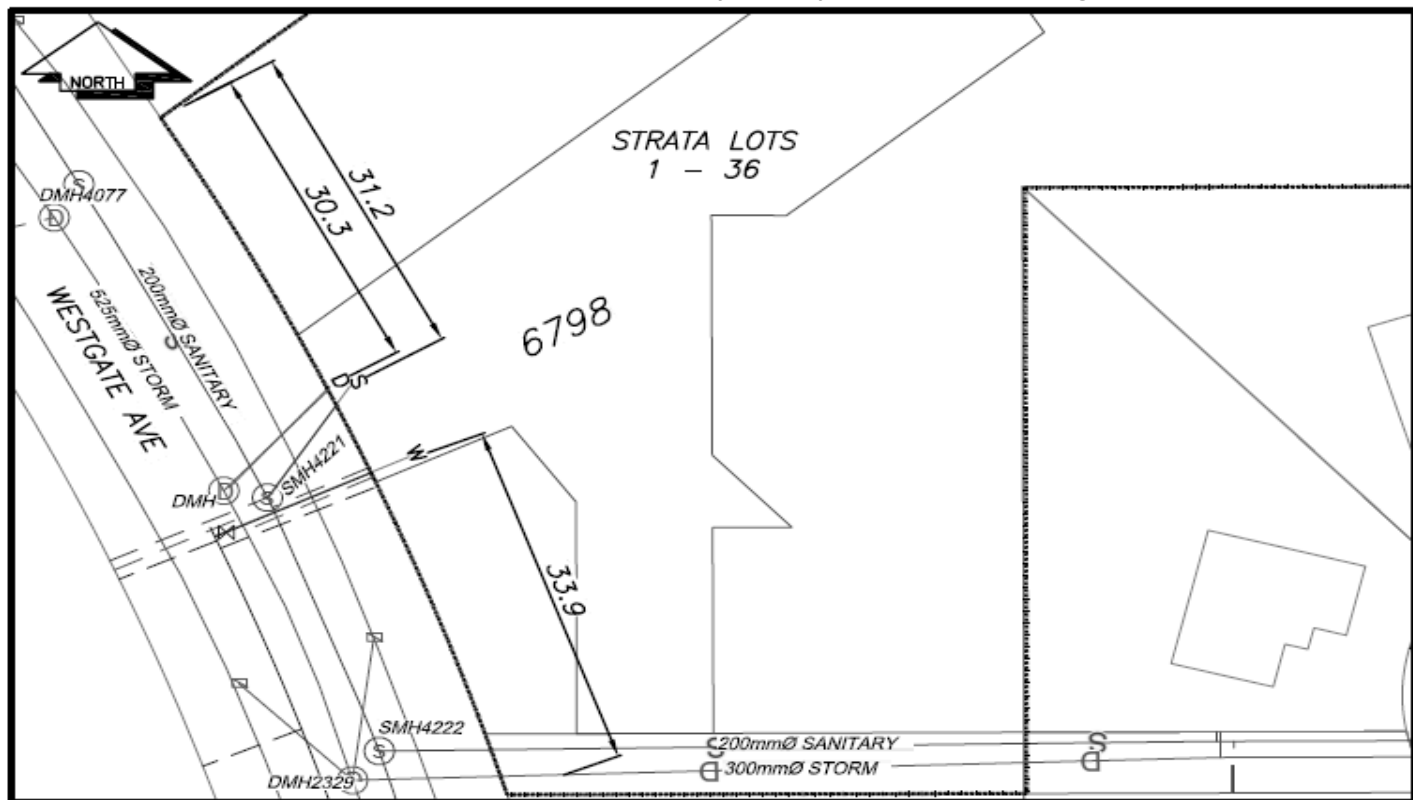

CS ^o CURB STOP	--- W WATER SERVICE	--- S STORM SERVICE
CO ^o CLEAN OUT	--- S SANITARY SERVICE	--- G GAS
⊗ WATER VALVE	⊗ FIRE HYDRANT	--- ENCUMBRANCE

NOT TO SCALE