



City of Prince George History Sheet

PID:	
MU:	101728
WO:	87756

Civic Address: 1444 20th Ave

Legal Description: District Lot: 343 Plan: EPS4459


Service Type	Diameter (mm)	Material	Invert Elev at main (m)	Invert Elev at property line (m)	Invert Elev at service end (m)	Distance into property (m)	Installation Date
Sanitary	300mm	PVC	-	-	-	4.87	September 2008
Water	200mm	PVC	-	-	-	-	April 2016
Storm	N/A	N/A	-	-	-	-	

Service Connection Location	Sanitary (m)	Storm (m)
300mm Sanitary Service connected to San MH 3292	-	
Distance from downstream Stm MH - towards upstream Stm MH -		

Power	Size	Communications	Size	Cable	Size	Gas	Size
BC Hydro	-	Telus	-	Shaw	-	FortisBC	-
Underground Service		Underground Service		Underground Service			

Installed by:	City of Prince George forces	Survey Date:	-
Comments:	A 375mm Storm service services the adjacent property at the west property line.		

NOT TO SCALE The information contained herein is for internal use only.
Not to be relied on unless confirmed by site inspection and/or investigation.

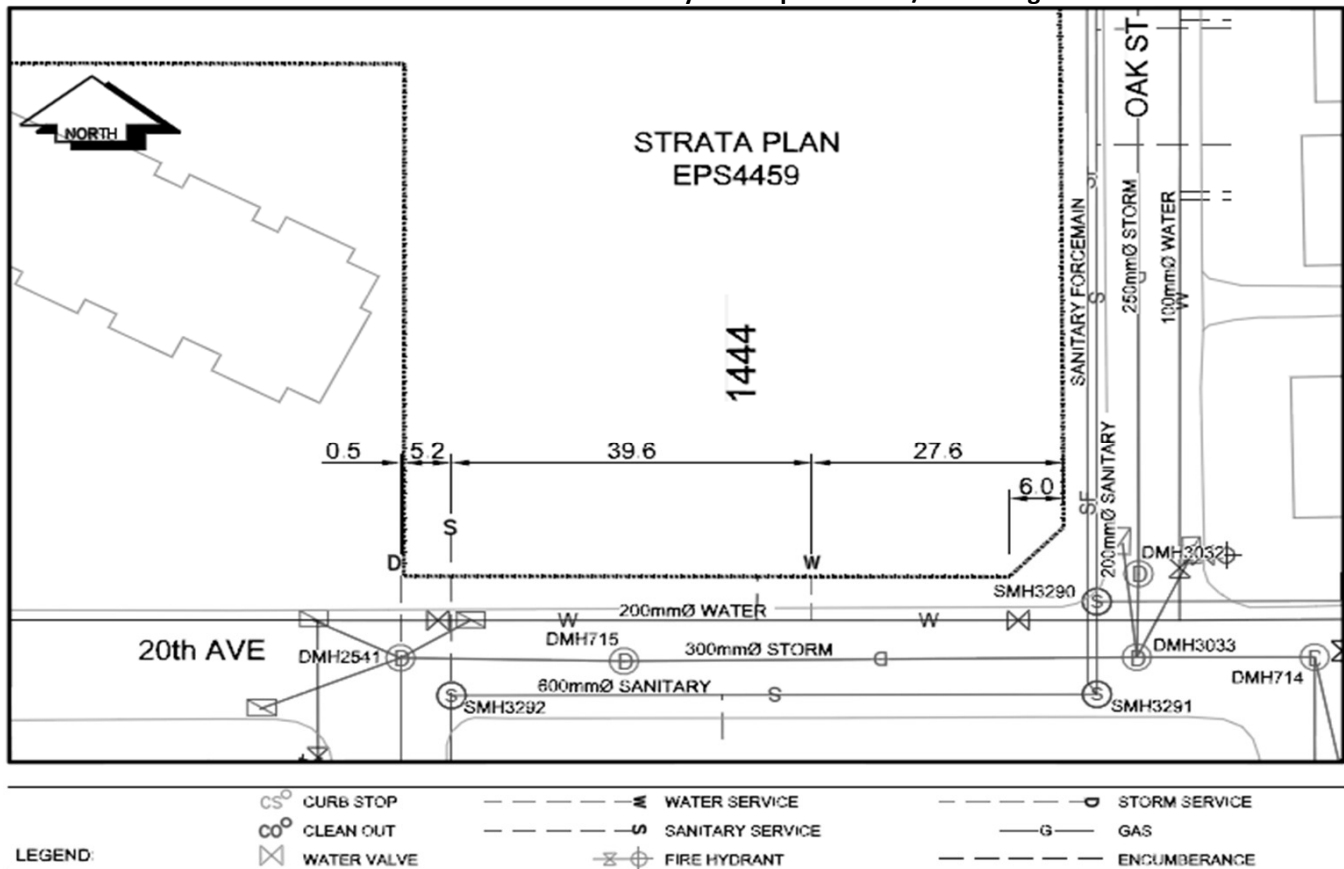

NOT TO SCALE