



# City of Prince George History Sheet

PID:	030236096
	030236100
SD/MU:	
WO:	

Civic Address: 7669, 7677 Creekside Way

Legal Description: SL 1 & SL 2 District Lot: 2014 Plan: EPS4538


Service Type	Diameter (mm)	Material	Invert Elev at main (m)	Invert Elev at property line (m)	Invert Elev at service end (m)	Distance into property (m)	Installation Date
Sanitary (S1)	100mm	PVC	582.28	583.59	2.58	-	September 2010
Sanitary (S2)	100mm	PVC	582.29	583.00	2.69	-	September 2010
Water (W1)	20mm	Copper	583.72	583.17	2.70	-	September 2010
Water (W2)	20mm	Copper	583.70	583.40	2.92	-	September 2010
Storm (D1)	100mm	PVC	582.52	583.61	2.64	-	September 2010
Storm (D2)	100mm	PVC	582.42	583.68	2.79	-	September 2010

Service Connection Location				Sanitary (m)	Storm (m)
Distance from downstream San MH	-	towards upstream San MH	-	-	
Distance from downstream Stm MH	-	towards upstream Stm MH	-		

Power	Size	Communications	Size	Cable	Size	Gas	Size
BC Hydro	75mm DB2	Telus	50mm DB2	Shaw	-	FortisBC	-
Underground Service		Underground Service		Underground Service			

Installed by:	Fortwood Homes Ltd.	Survey Date:	-
Comments:			

**NOT TO SCALE** The information contained herein is for internal use only.  
Not to be relied on unless confirmed by site inspection and/or investigation.

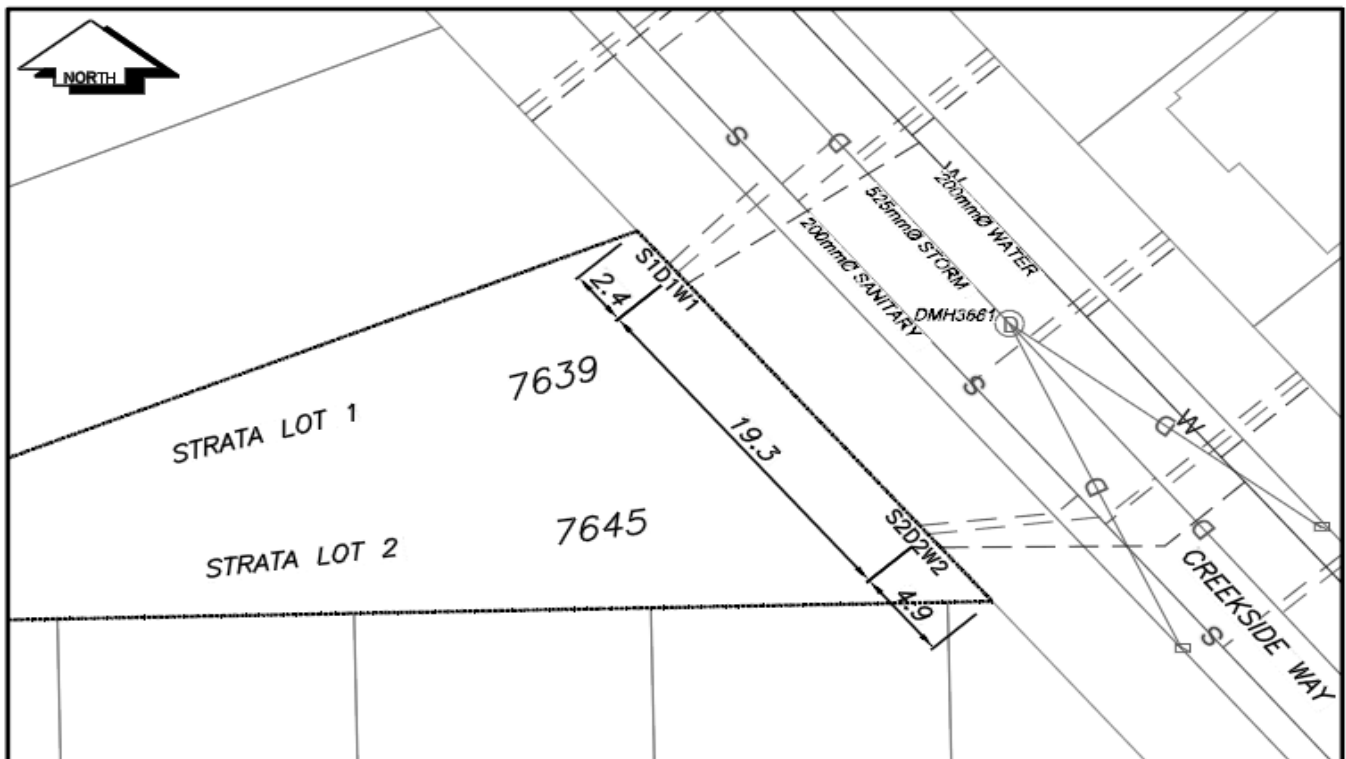

CS CURB STOP	--- WATER SERVICE	--- STORM SERVICE
CO CLEAN OUT	--- SANITARY SERVICE	--- GAS
WATER VALVE	--- FIRE HYDRANT	--- ENCUMBRANCE

**NOT TO SCALE**