



City of Prince George History Sheet

PID:	030560535
SD/MU:	
WO:	

Civic Address: 4393 CowartRd

Legal Description: Lot: SL 9 District Lot: 753 Plan: EPS4560


Service Type	Diameter (mm)	Material	Invert Elev at main (m)	Invert Elev at property line (m)	Invert Elev at service end (m)	Distance into property (m)	Installation Date
Sanitary	200mm	PVC	591.84	593.00	-	-	May 2017
Water	200mm	PVC	604.44	604.70	605.80	-	May 2017
Storm	200mm	PVC	588.90	592.40	-	-	May 2017

Service Connection Location	Sanitary (m)	Storm (m)
200mm Sanitary service connected to San MH4923	-	
Distance from downstream Stm MH - towards upstream Stm MH -		

Power	Size	Communications	Size	Cable	Size	Gas	Size
BC Hydro	-	Telus	-	Shaw	-	FortisBC	-
Underground Service		Underground Service		Underground Service			

Installed by:	Survey Date:	-
Comments:		

NOT TO SCALE The information contained herein is for internal use only.
Not to be relied on unless confirmed by site inspection and/or investigation.

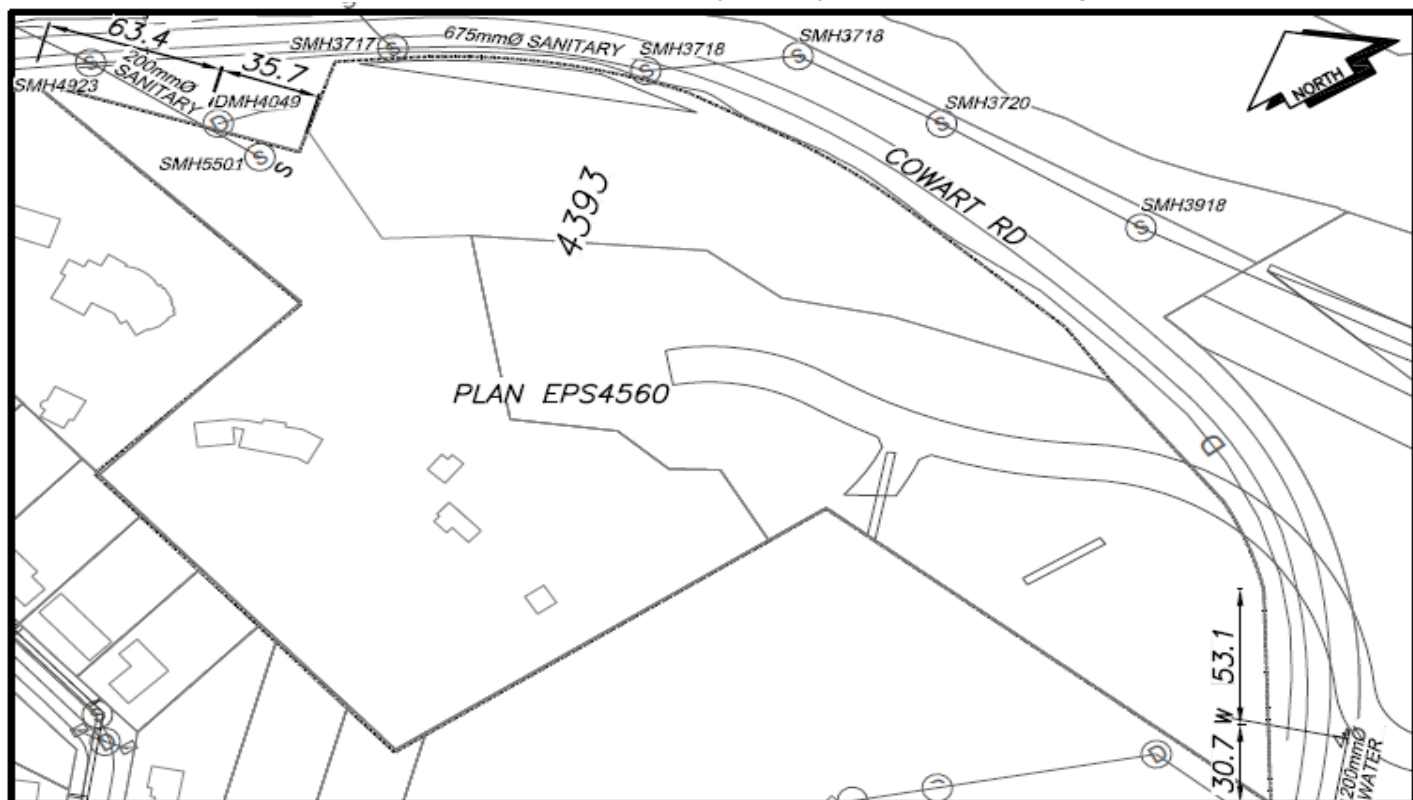

CS ^o CURB STOP	— W — WATER SERVICE	— S — STORM SERVICE
CO ^o CLEAN OUT	- - - - - S SANITARY SERVICE	— G — GAS
⊗ WATER VALVE	⊗ FIRE HYDRANT	- - - - - ENCUMBRANCE

NOT TO SCALE