



City of Prince George
History Sheet

PID:	EPS495
SD/MU:	100331/101156+
WO:	58929 - 58931

Civic Address: 6525 Domano Blvd

Legal Description: Lot: CMLPX District Lot: 754 Plan: EPS495


Service Type	Diameter (mm)	Material	Invert Elev at main (m)	Invert Elev at property line (m)	Invert Elev at service end (m)	Distance into property (m)	Installation Date
Sanitary	150mm	PVC	-	-	610.10	-	May 2011
Water	150mm	PVC	-	-	-	-	May 2011
Storm	500mm	PVC	-	-	611.14	-	May 2011

Service Connection Location	Sanitary (m)	Storm (m)
Sanitary service connected to San MH 3815	-	
Storm service connected to Stm MH 1424		

Power	Size	Communications	Size	Cable	Size	Gas	Size
BC Hydro	-	Telus	-	Shaw	-	FortisBC	-
Underground Service		Underground Service		Underground Service			

Installed by:	City of Prince George forces	Survey Date:	-
Comments:			

NOT TO SCALE The information contained herein is for internal use only.
Not to be relied on unless confirmed by site inspection and/or investigation.

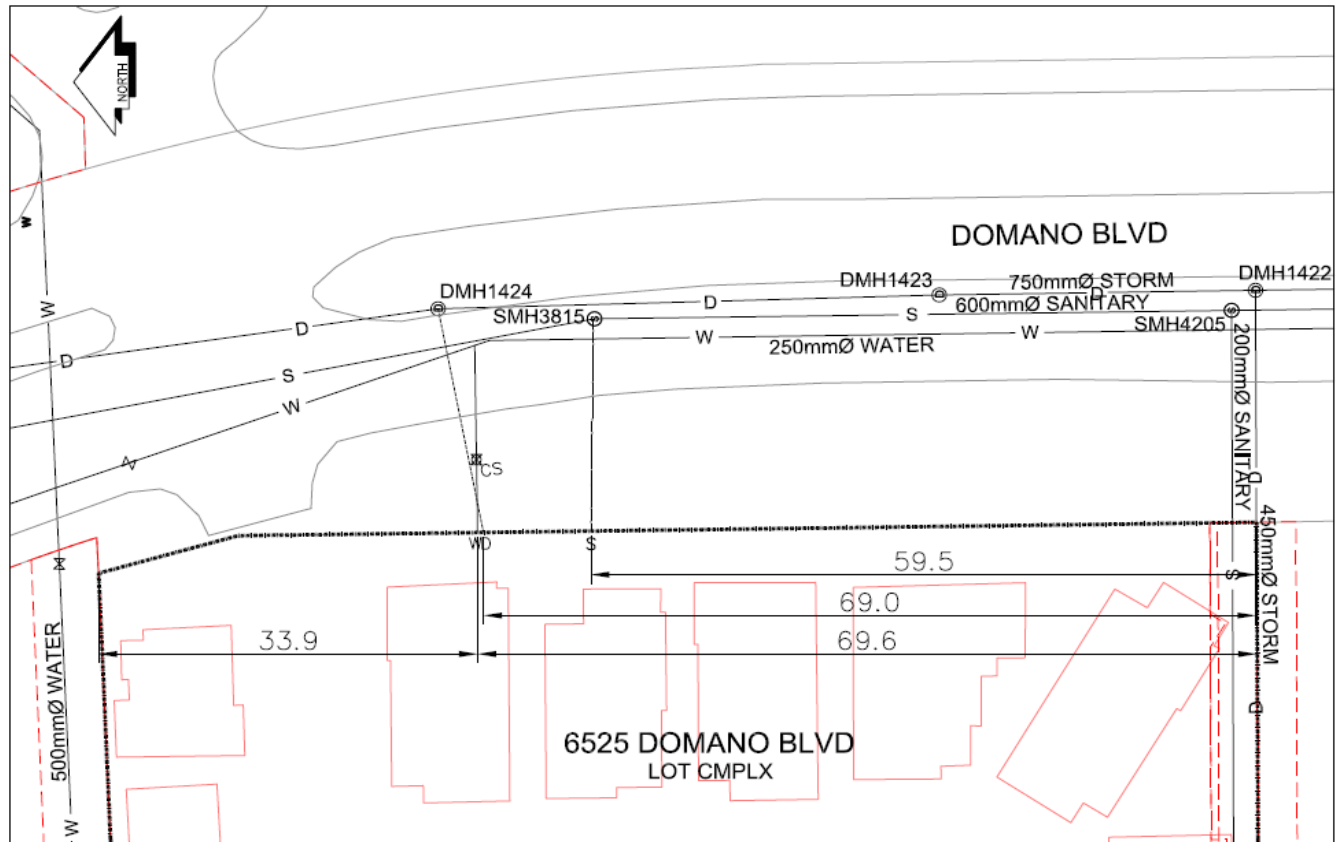

LEGEND:	CS CURB STOP	--- WATER SERVICE	--- STORM SERVICE
	CO CLEAN OUT	--- SANITARY SERVICE	⊗ WATER VALVE

NOT TO SCALE