

Legal Description: Lot: CMPLX District Lot: 343 Plan: EPS5428 (9 STRATA LOTS)

Service Type	Diameter (mm)	Material	Invert Elev @ Main (m)	Invert Elev @ Property Line (m)		Invert Elev @ Service End (m)	Distance into Property (m)	Installation Date
Sanitary	100	PVC	575.59	-		575.66	-	December 1955
Water	150	PVC	575.48	575.24		575.23	-	May 2018
Storm	100	PVC	575.32	-		-	-	May 2018
Sanitary Service Connection Location Notes					Storm Service Connection Location Notes			
Distance from downstream SAN MH #3096: 120.35m					Distance from downstream STM MH #: N/A			
Distance to upstream SAN MH #5634: 4.50m					Distance to upstream STM MH #: N/A			
Miscellaneous Utilities								
Power		С	Communications		Cable		Gas	
BC H		TELUS		S	haw Cable	FortisBC		
Overhead Service		C	Overhead Service		Ove	rhead Service	Underground Service	
		L						

Installation By: City of Prince George


Comments:

Draft Date:

Water Service is ~12.8m East from the Southwest corner of Lot EPS5428. Sanitary Service is ~7.3m West from the Northeast corner of Lot EPS5428.

Storm Service is ~13.1m South from the Northwest corner of Lot EPS5428. MU# 101908. WO# 94143. WO# 94149.

NOT TO SCALE The information contained herein is for internal use only. Not to be relied on unless confirmed by site inspection and/or investigation.

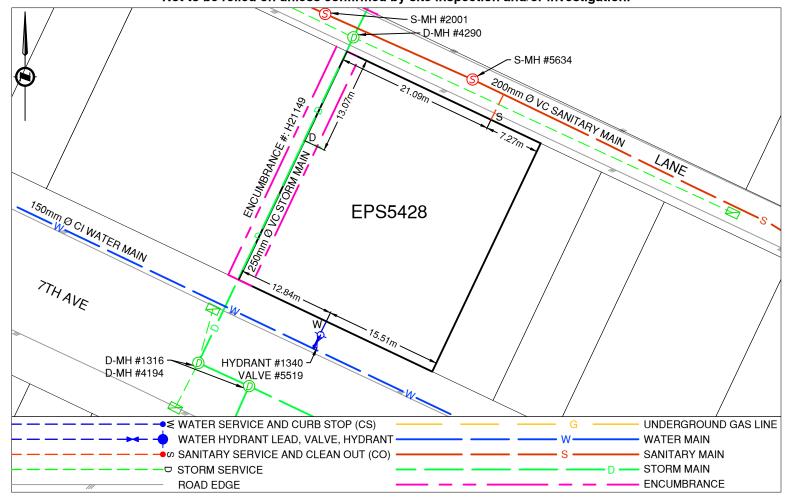

Survey Date:

2023-01-31

May 2018