



City of Prince George History Sheet

PID:	EPS5922
MU:	102114
WO:	99505/99506

Civic Address: 4648, 4650 Chief Lake Rd

Legal Description: Lot: SL 1 SL2 District Lot: 2424 Plan: EPS5922


Service Type	Diameter (mm)	Material	Invert Elev at main (m)	Invert Elev at property line (m)	Invert Elev at service end (m)	Distance into property (m)	Installation Date
Sanitary	150mm	PVC	-	-	-	5.51	September 2019
Water (W1)	25mm	Copper	751.80	751.75	751.73	3.00	September 2019
Water (W2)	25mm	Copper	751.85	751.66	751.78	3.00	September 2019
Storm	N/A	N/A	-	-	-	-	

Service Connection Location	Sanitary (m)	Storm (m)
150mm Sanitary service connected to San MH116	-	
Distance from downstream Stm MH - towards upstream Stm MH -		

Power	Size	Communications	Size	Cable	Size	Gas	Size
BC Hydro	-	Telus	-	Shaw	-	FortisBC	-
Overhead Service		Overhead Service		Overhead Service			

Installed by: City of Prince George forces	Survey Date: -
Comments:	

NOT TO SCALE The information contained herein is for internal use only.
Not to be relied on unless confirmed by site inspection and/or investigation.

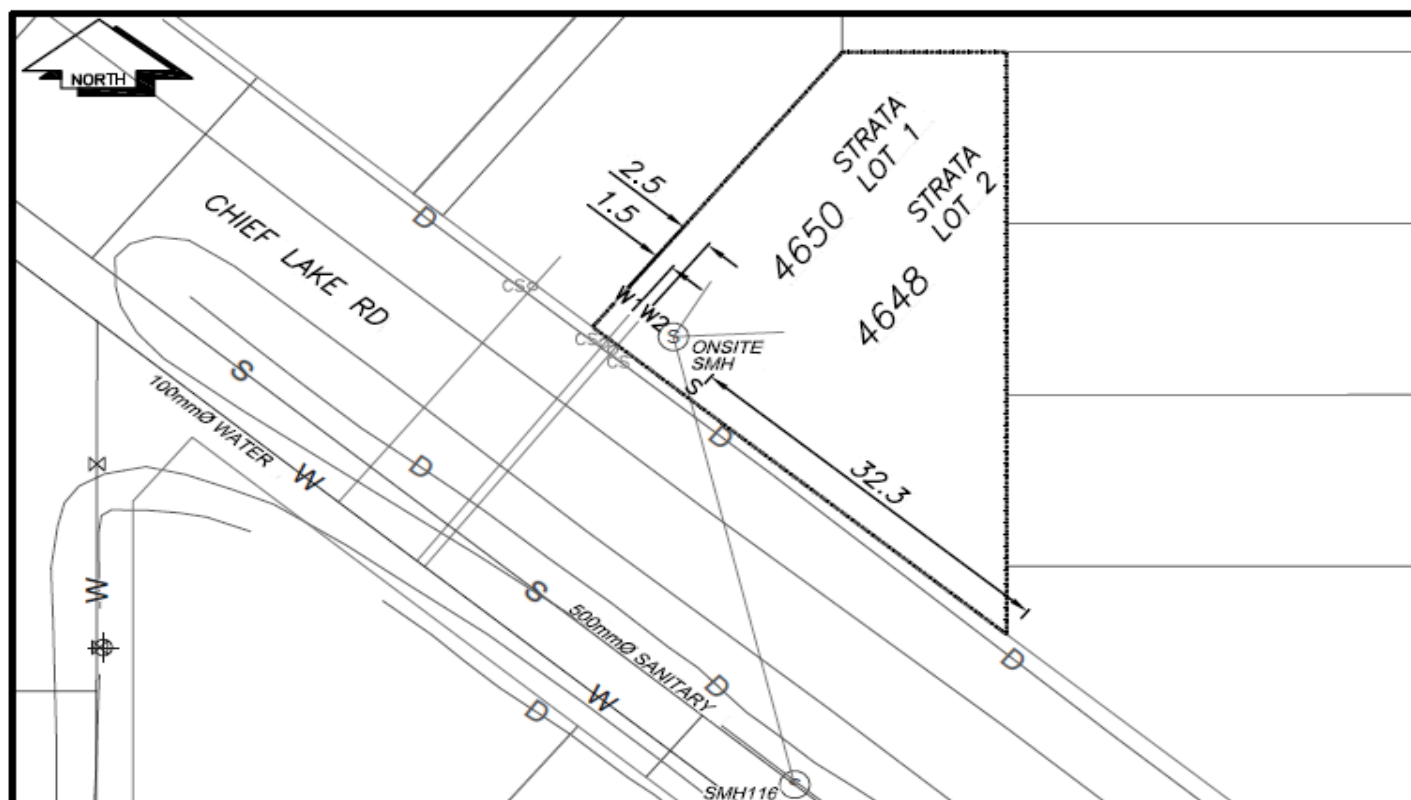

CS CURB STOP	WATER SERVICE	STORM SERVICE
CO CLEAN OUT	SANITARY SERVICE	GAS
WATER VALVE	FIRE HYDRANT	ENCUMBRANCE

NOT TO SCALE