



City of Prince George History Sheet

PID:	030858461
	030858470
MU:	102097
WO:	99487/99488

Civic Address: 4014, 4016 Knight Cres

Legal Description: Lot: SL 1 & SL 2 District Lot: 2433 Plan: EPS6097


Service Type	Diameter (mm)	Material	Invert Elev at main (m)	Invert Elev at property line (m)	Invert Elev at service end (m)	Distance into property (m)	Installation Date
Sanitary (S1)	100mm	PVC	-	739.80	-2.11	-	December 1985
Sanitary (S2)	100mm	PVC	739.30	739.61	739.40	-	June 2019
Water (W1)	20mm	Copper	-	-	-	-	December 1977
Water (W2)	20mm	Copper	739.45	739.49	739.57	-	June 2019
Storm	N/A	N/A	-	-	-	-	

Service Connection Location				Sanitary (m)	Storm (m)
Distance from downstream San MH	74	towards upstream San MH	73	87.45	
Distance from downstream San MH	74	towards upstream San MH	73	84.91	

Power	Size	Communications	Size	Cable	Size	Gas	Size
BC Hydro	-	Telus	-	Shaw	-	FortisBC	-
Overhead Service		Overhead Service		Overhead Service			

Installed by:	City of Prince George forces	Survey Date:	-
Comments:			

NOT TO SCALE The information contained herein is for internal use only.
Not to be relied on unless confirmed by site inspection and/or investigation.

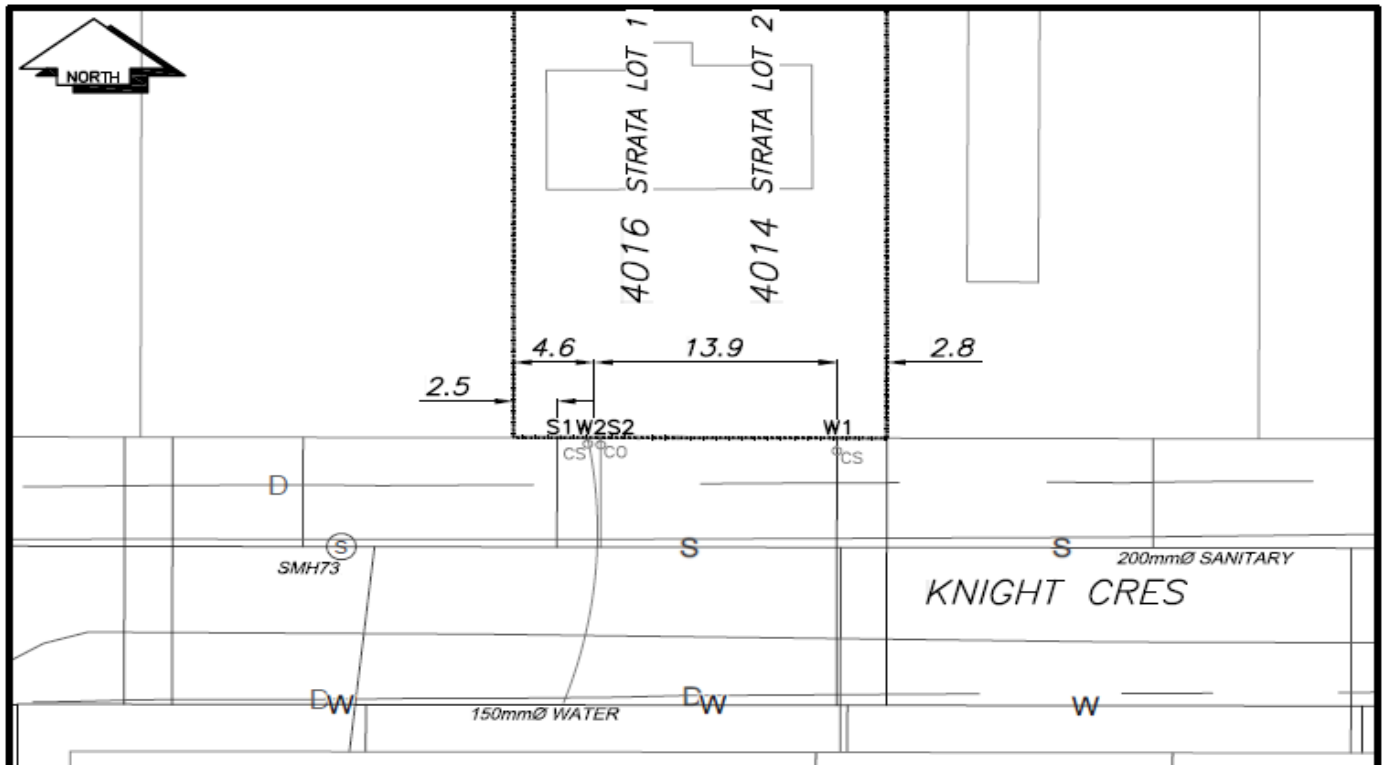

CS ^o CURB STOP	—≡— WATER SERVICE	—o— STORM SERVICE
CO ^o CLEAN OUT	- - - - - SANITARY SERVICE	—G— GAS
⊗ WATER VALVE	—⊕— FIRE HYDRANT	- - - - - ENCUMBERANCE

NOT TO SCALE