



# City of Prince George History Sheet

PID:	030591627
MU:	102037
WO:	97035/97034

Civic Address: 2422 Vanier Dr  
Legal Description: Strata Plan EPS6232


Service Type	Diameter (mm)	Material	Invert Elev at main (m)	Invert Elev at property line (m)	Invert Elev at service end (m)	Distance into property (m)	Installation Date
Sanitary	150mm	PVC	596.15	596.17	596.23	1.20	October 2018
Water	200mm	PVC	595.47	595.78	595.88	1.50	October 2018
Storm	N/A	N/A	-	-	-	-	

Service Connection Location	Sanitary (m)	Storm (m)
150mm Sanitary service connected to San MH1063	-	
Distance from downstream Stm MH - towards upstream Stm MH -		

Power	Size	Communications	Size	Cable	Size	Gas	Size
BC Hydro	-	Telus	-	Shaw	-	FortisBC	-
Underground Service		Underground Service		Underground Service			

Installed by: City of Prince George forces	Survey Date: -
Comments:	

**NOT TO SCALE** The information contained herein is for internal use only.  
Not to be relied on unless confirmed by site inspection and/or investigation.

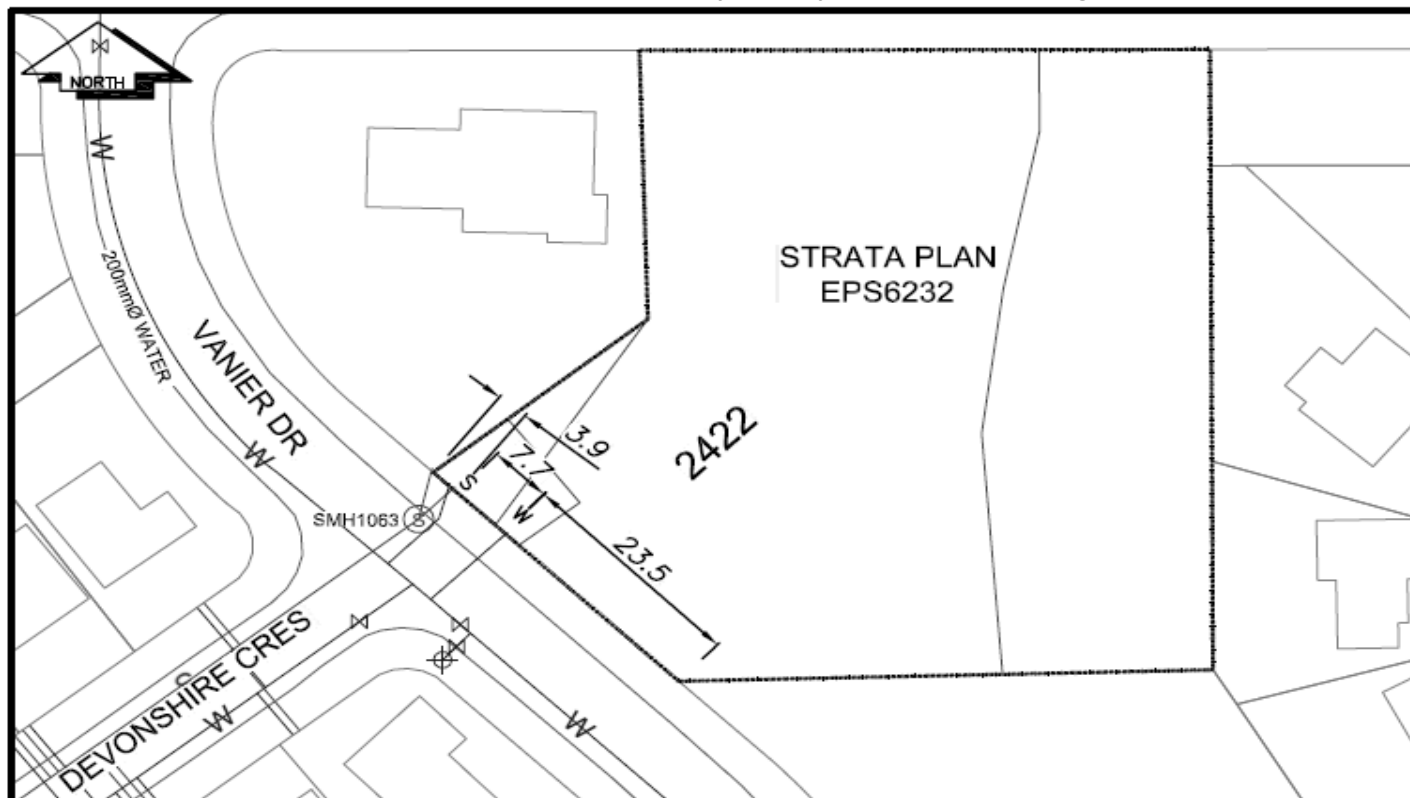

CS CURB STOP	W WATER SERVICE	STORM SERVICE
CO CLEAN OUT	S SANITARY SERVICE	G GAS
WATER VALVE	FIRE HYDRANT	ENCUMBERANCE

**NOT TO SCALE**