



City of Prince George History Sheet

PID:	031072411
	031072429
MU:	102096
WO:	99347

Civic Address: 3907. 3905 Richet St

Legal Description: Strata Plan EPS6518


Service Type	Diameter (mm)	Material	Invert Elev at main (m)	Invert Elev at property line (m)	Invert Depth at service end (m)	Distance into property (m)	Installation Date
Sanitary	100mm	PVC	-	738.52	3.01	-	December 1979
Water (W1)	20mm	Copper	-	-	-	-	December 1981
Water (W2)	20mm	Copper	739.37	739.43	739.41	1.70	August 2019
Storm	N/A	N/A	-	-	-	-	

Service Connection Location				Sanitary (m)	Storm (m)
Distance from downstream San MH	355	towards upstream San MH	356	104.74	
Distance from downstream Stm MH	104.74-	towards upstream Stm MH	-		

Power	Size	Communications	Size	Cable	Size	Gas	Size
BC Hydro	-	Telus	-	Shaw	-	FortisBC	-
Overhead Service		Overhead Service		Overhead Service			

Installed by:	City of Prince George forces	Survey Date:	-
Comments:			

NOT TO SCALE The information contained herein is for internal use only.
Not to be relied on unless confirmed by site inspection and/or investigation.

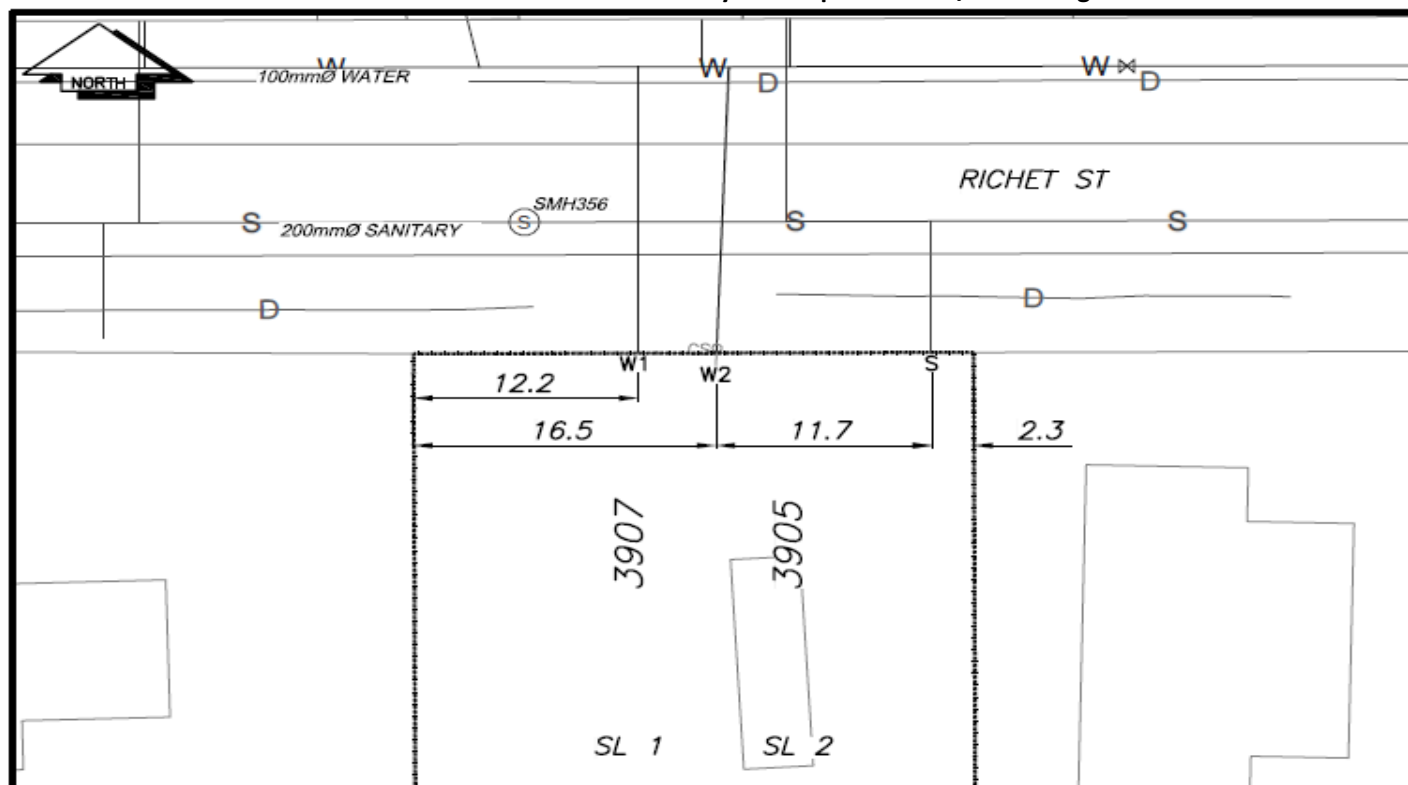

CS ^o CURB STOP	—≡— WATER SERVICE	—o— STORM SERVICE
CO ^o CLEAN OUT	- - - - - SANITARY SERVICE	—G— GAS
⊗ WATER VALVE	—⊗— FIRE HYDRANT	- - - - - ENCUMBRANCE

NOT TO SCALE