



# City of Prince George History Sheet

PID:	031080723
SD/MU:	102082
WO:	97551/97550

Civic Address: 4274, 4278 22nd Ave

Legal Description: Lot: A District Lot: 2611 Plan: EPP99871/ Strata Plan EPS6571


Service Type	Diameter (mm)	Material	Invert Elev at main (m)	Invert Elev at property line (m)	Invert Elev at service end (m)	Distance into property (m)	Installation Date
Sanitary	200mm	PVC	602.05	-	602.18	-1.50	October 2018
Water	200mm	PVC	601.18	601.12	601.12	-	October 2018
Storm	N/A	N/A	-	-	-	-	

Service Connection Location	Sanitary (m)	Storm (m)
200mm Sanitary service connection connected to san MH5458	-	
Distance from downstream Stm MH - towards upstream Stm MH -		

Power	Size	Communications	Size	Cable	Size	Gas	Size
BC Hydro	-	Telus	-	Shaw	-	FortisBC	-
Overhead Service		Overhead Service		Overhead Service			

Installed by: City of Prince George forces	Survey Date: -
Comments:	

**NOT TO SCALE** The information contained herein is for internal use only.  
Not to be relied on unless confirmed by site inspection and/or investigation.

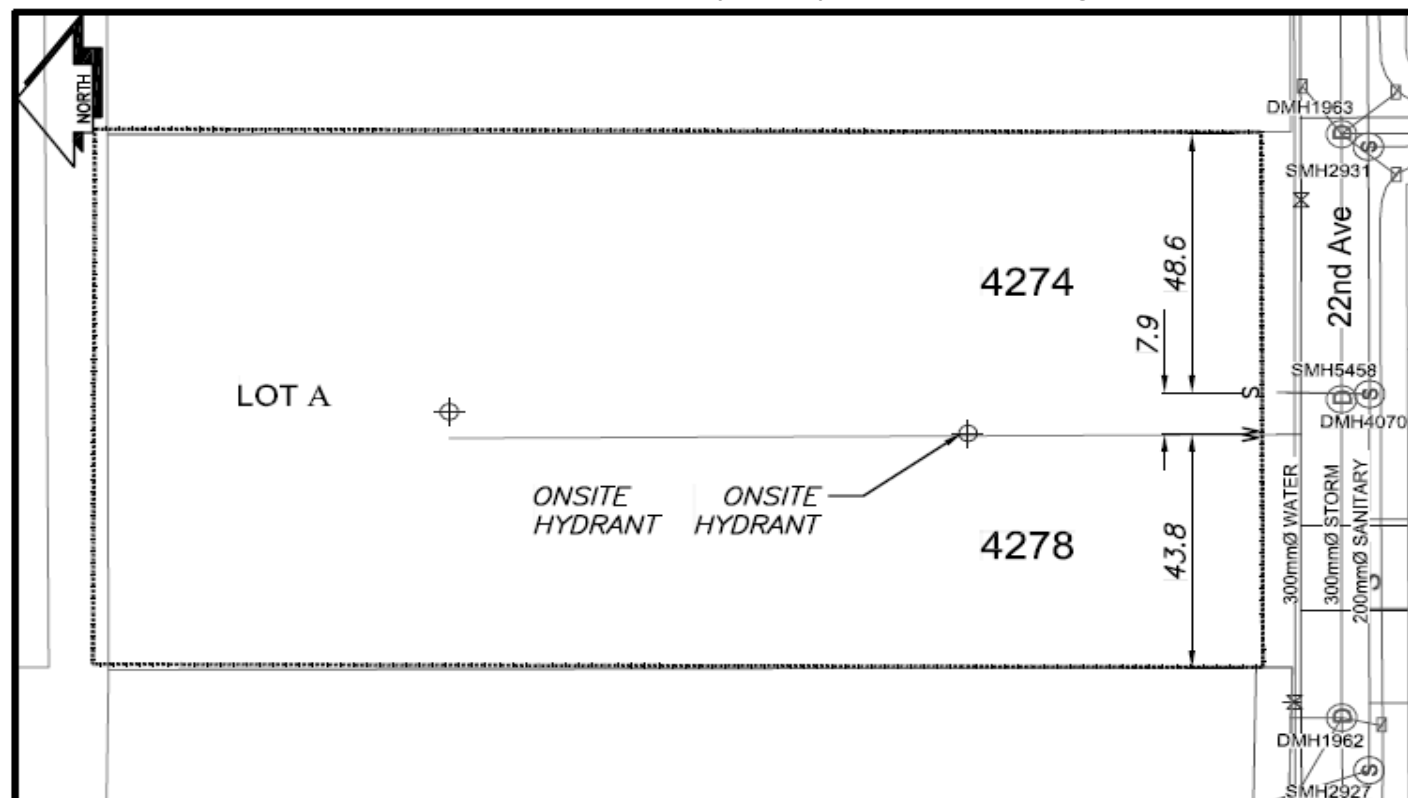

CS CURB STOP	— — — — — WATER SERVICE	— — — — — STORM SERVICE
CO CLEAN OUT	— — — — — SANITARY SERVICE	— — — — — GAS
⊗ WATER VALVE	⊗ FIRE HYDRANT	— — — — — ENCUMBRANCE

**NOT TO SCALE**