



City of Prince George
History Sheet

PID:	031272291
	031272304
MU:	102265
WO:	103327/103328

Civic Address: 6766, 6770 Hart Hwy

Legal Description: Strata Plan EPS7253


Service Type	Diameter (mm)	Material	Invert Elev at main (m)	Invert Elev at property line (m)	Invert Depth at service end (m)	Distance into property (m)	Installation Date
Sanitary (S1)	100mm	PVC	-	-	2.71	-	December 1979
Water (W1)	20mm	Copper	-	-	-	-	December 1971
Sanitary (S2)	100mm	PVC	733.88	734.70	734.77	1.00	July 2020
Water (W2)	20mm	Copper	734.49	734.80	734.80	1.00	July 2020
Storm	N/A	N/A	-	-	-	-	

Service Connection Location				Sanitary (m)	Storm (m)
Distance from downstream San MH	358	towards upstream San MH	354	36.53	
Distance from downstream Stm MH	-	towards upstream Stm MH	-		

Power	Size	Communications	Size	Cable	Size	Gas	Size
BC Hydro	-	Telus	-	Shaw	-	FortisBC	-
Overhead Service		Overhead Service		Overhead Service			

Installed by:	Services W2 and S2 installed by City of Prince George forces	Survey Date:	-
Comments:			

NOT TO SCALE The information contained herein is for internal use only.
Not to be relied on unless confirmed by site inspection and/or investigation.

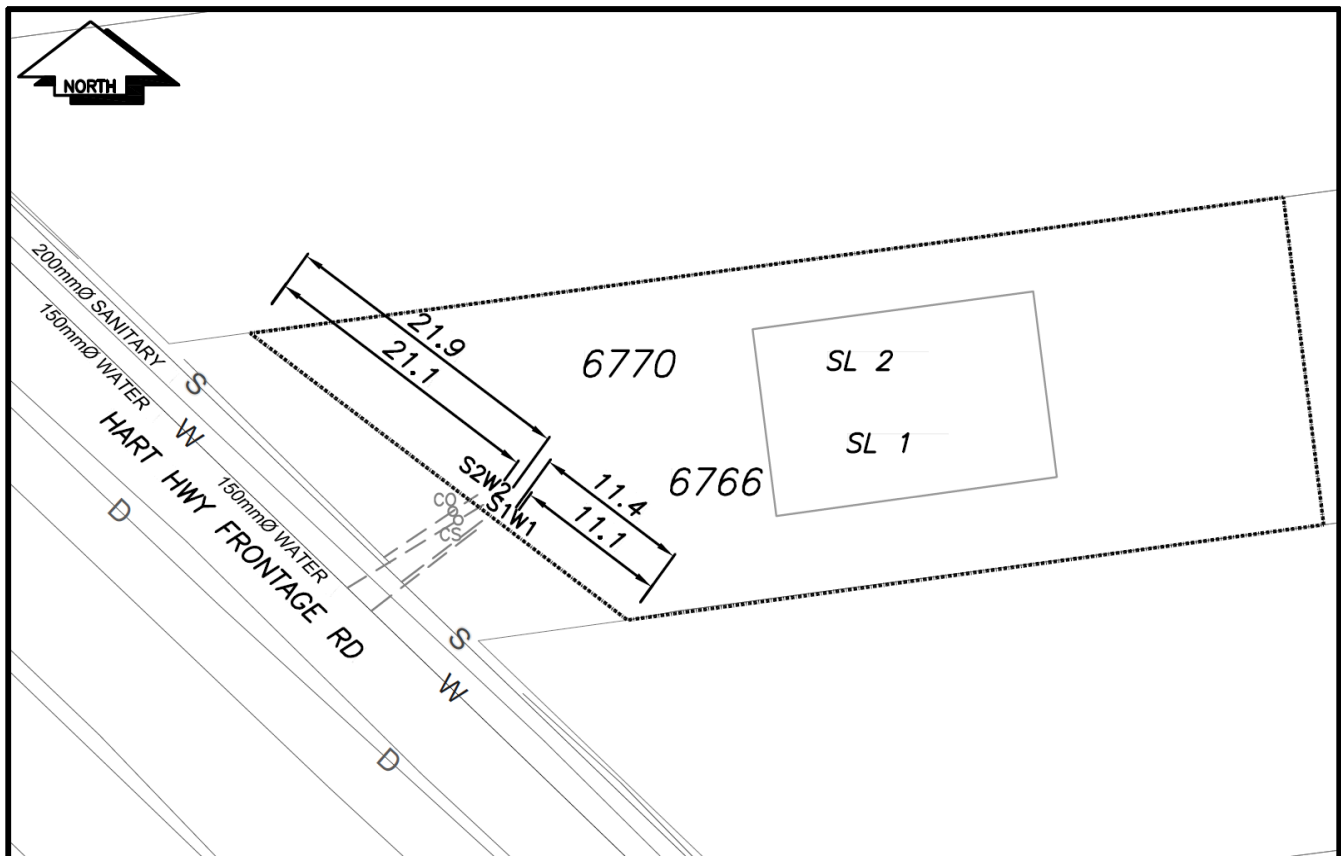

CS	CURB STOP	NOT TO SCALE	WATER SERVICE	STORM SERVICE
CO	CLEAN OUT	---	SANITARY SERVICE	GAS
WV	WATER VALVE	⊕	FIRE HYDRANT	ENCUMBRANCE