



# City of Prince George


## HISTORY SHEET

**LEGEND:**

CS CURB STOP	— W WATER SERVICE	— H HYDRO SERVICE	— GAS GAS
CO CLEAN OUT	— SD STORM SERVICE	— T TELECOMMUNICATIONS	— UG UG
	— S SANITARY SERVICE		— SHALLOW SHALLOW UTILITIES



1. PROPERTY LINES SHOWN ARE APPROXIMATE.
2. UNDERGROUND SERVICES AND LOCATIONS ARE APPROXIMATE AND MUST BE VERIFIED BEFORE EXCAVATION.

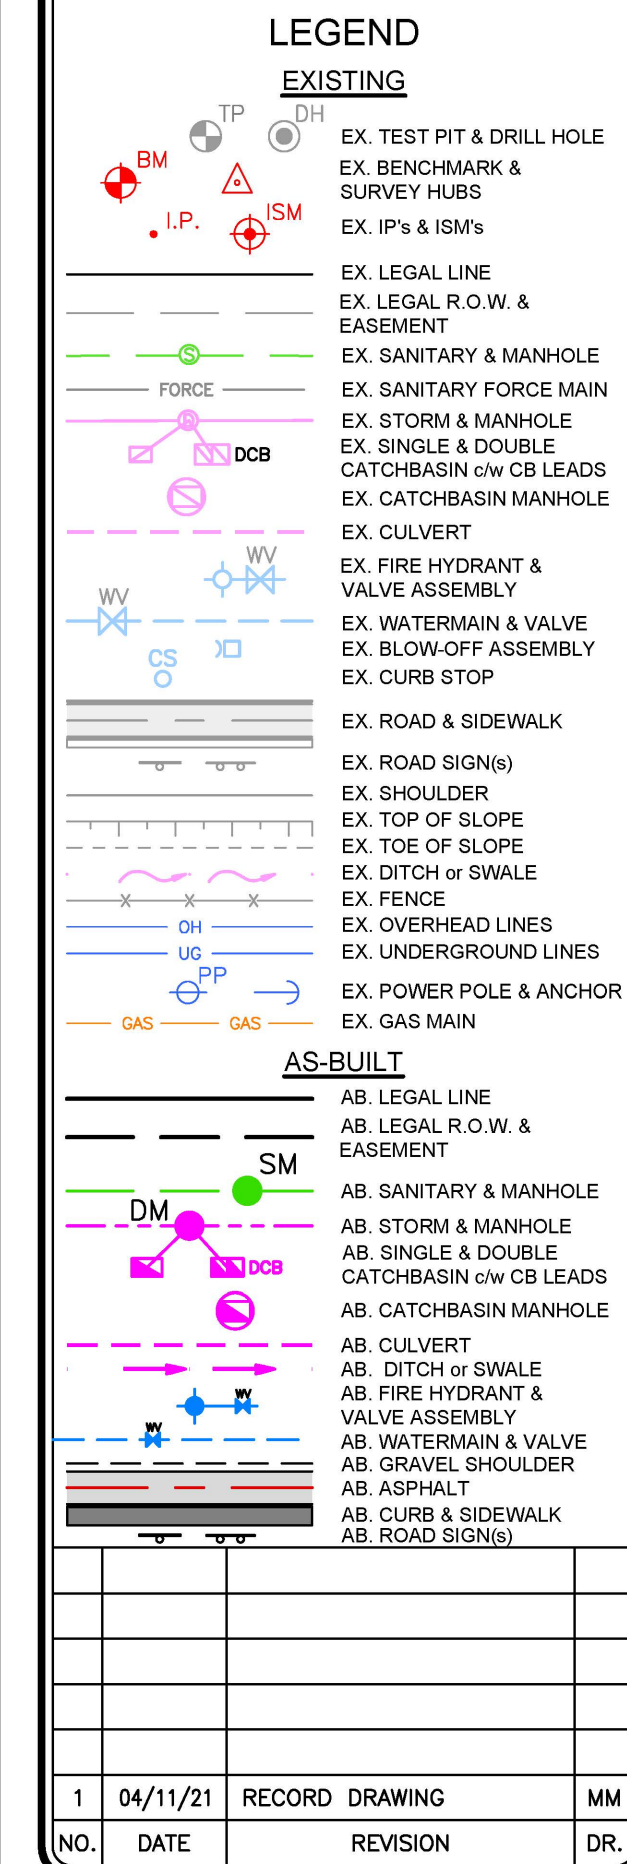

DRAWN:	DDA
CHECKED:	JRB
ENGINEER:	JRB
SURVEY FILE:	
DRAWING FILE:	C3D18-1618-01 Offsite Works AB.dwg
CORRESPONDENCE:	CPG
GRID:	
DATE:	DECEMBER 2018
SCALES:	FULL 1:400

HAYER PROPERTIES  
6605 SOUTHRIDGE AVENUE  
HOUSING DEVELOPMENT

OVERALL SITE PLAN

CONSULTANTS PROJECT No.

1618-01

DRAWING No.

AB-C001

SHEET No.	REV. No.
1 OF 2	1

The City of Prince George does not represent or guarantee that the information contained in this document is accurate or reliable, and any person who relies on this information in this document does so at their own risk.

City of Prince George

This information has been provided subject to the *Federal Copyright Act* and in accordance with the *Provincial Freedom of Information and Protection of Privacy Act*.

ISSUED FOR RECORD DRAWING



ENGINEERING LIMITED  
PERMIT TO PRACTICE 1002375

1210 FOURTH AVENUE  
PRINCE GEORGE, B.C.  
V2L 3J4  
TEL. (250) 562-1977  
FAX (250) 562-1967