



City of Prince George
History Sheet

PID:	PGS168
SD/MU:	
WO:	

Civic Address: 448 Tabor Blvd

Legal Description: Lot: SL 1 - 9 District Lot: 2507 Plan: PGS168


Service Type	Diameter (mm)	Material	Invert Elev at main (m)	Invert Elev at property line (m)	Invert Elev at service end (m)	Distance into property (m)	Installation Date
Sanitary	200mm	AC	-	-	-	-	January 1973
Water	150mm	AC	-	-	-	-	January 1974
Storm	375mm	CONC	-	-	-	-	January 1973

Service Connection Location	Sanitary (m)	Storm (m)
200mm Sanitary Service connected to San MH2555	-	
375mm Storm service connected to Stm MH382		

Power	Size	Communications	Size	Cable	Size	Gas	Size
BC Hydro	-	Telus	-	Shaw	-	FortisBC	-
Underground Service		Underground Service		Underground Service			

Installed by:	Survey Date:	-
Comments: Sanitary, Water and Storm services through easement on Lot A		

NOT TO SCALE The information contained herein is for internal use only.
Not to be relied on unless confirmed by site inspection and/or investigation.

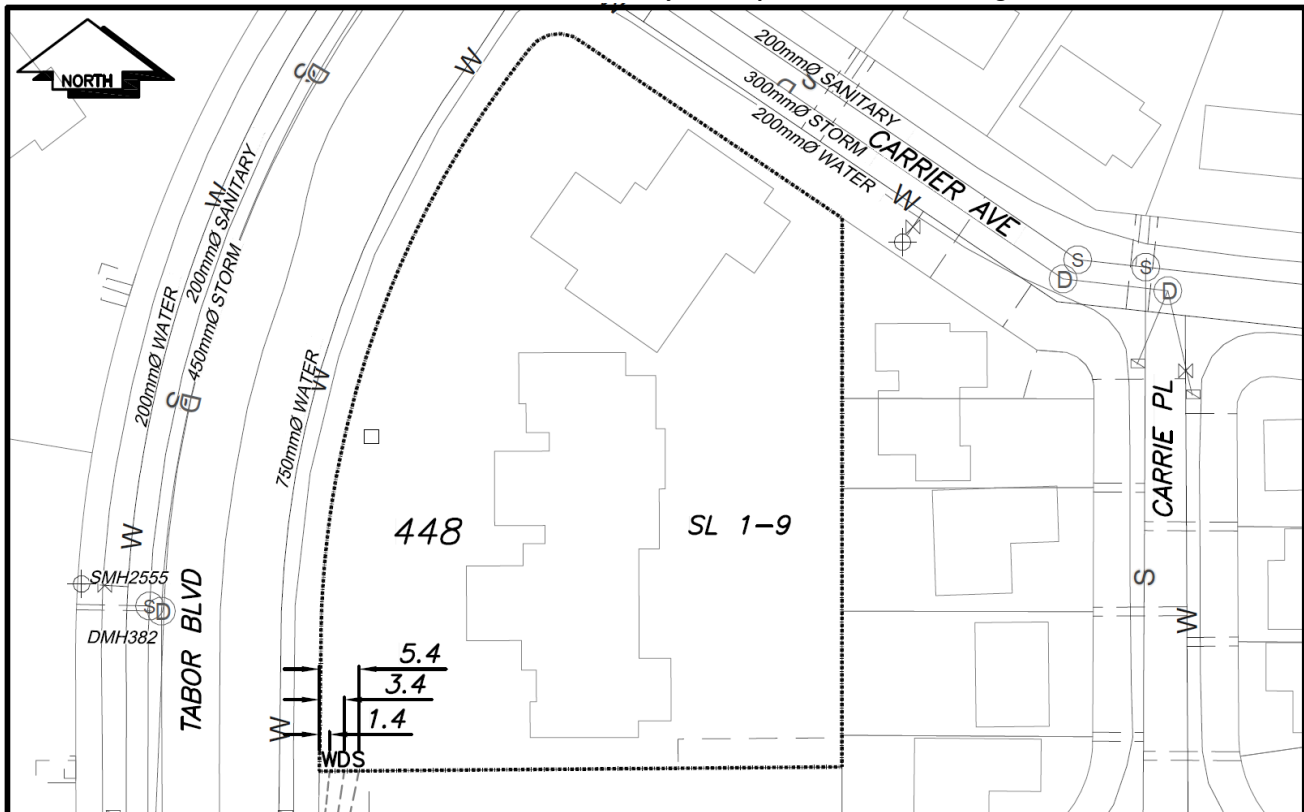

CS ^o CURB STOP	W WATER SERVICE	o STORM SERVICE
CO ^o CLEAN OUT	- - - - - SANITARY SERVICE	- G - GAS
X WATER VALVE	X FIRE HYDRANT	- - - - - ENCUMBRANCE

NOT TO SCALE