



City of Prince George
History Sheet

PID:	PGS2
SD/MU:	
WO:	

Civic Address: 111 Tabor Blvd

Legal Description: Lot: CMLPX District Lot: 2507 Plan: PGS2


Service Type	Diameter (mm)	Material	Invert Elev at main (m)	Invert Elev at property line (m)	Invert Elev at service end (m)	Connection #	Installation Date
Sanitary	200mm	AC	-	-	-	9538	-
Sanitary	200mm	AC	-	-	-	9537	-
Water	150mm	AC	-	-	-	9538	-
Water	150mm	AC	-	-	-	9537	-
Water	50mm	Copper	-	-	-	-	-
Storm	250mm	Vit	-	-	-	483	-
Storm	250mm	Vit	-	-	-	484	-
Storm	250mm	AC	-	-	-	477	-

Service Connection Location	Sanitary (m)	Storm (m)
Connected to manholes as shown	-	-
Connected to manholes as shown	-	-

Power	Size	Communications	Size	Cable	Size	Gas	Size
BC Hydro	-	Telus	-	Shaw	-	FortisBC	-
Underground Service		Underground Service		Underground Service			

Installed by:	Survey Date:	-
Comments:		

NOT TO SCALE The information contained herein is for internal use only.
Not to be relied on unless confirmed by site inspection and/or investigation.

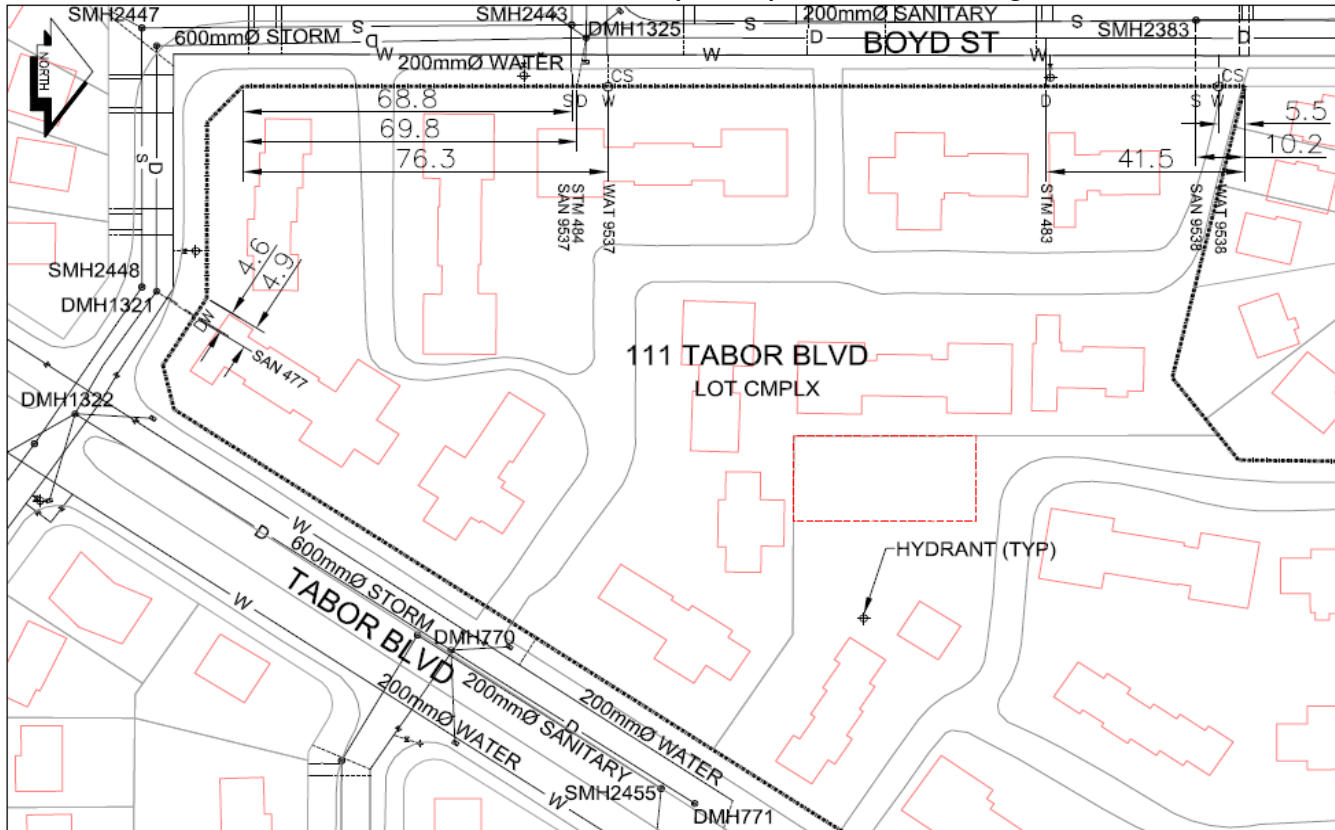

LEGEND:	CS CURB STOP	--- WATER SERVICE	--- STORM SERVICE
	CO CLEAN OUT	--- SANITARY SERVICE	⊗ WATER VALVE

NOT TO SCALE