



City of Prince George
History Sheet

PID:	
SD/MU:	
WO:	

Civic Address: 2055 Ingledew St

Legal Description: Lot: Strata Lot 1-96 District Lot: 417 Stata Plan: PGS239


Service Type	Diameter (mm)	Material	Invert Elev at main (m)	Invert Elev at property line (m)	Invert Depth at service end (m)	Distance into property (m)	Installation Date
Sanitary - S1	100mm	AC	573.44	575.15	2.10	-	January 1956
Sanitary -S2	200mm	AC	-	-	-	-	January 1956
Water - W1	20mm	Copper	-	-	-	-	January 1957
Water - W2	150mm	Cast Iron	-	-	-	-	November 1996
Storm	N/A	N/A	-	-	-	-	

Service Connection Location				Sanitary (m)	Storm (m)
Distance from downstream San MH	3311	towards upstream San MH	3312	51.10	
200mm Sanitary connected to San MH 3311					
Distance from downstream Stm MH	-	towards upstream Stm MH	-		

Power	Size	Communications	Size	Cable	Size	Gas	Size
BC Hydro	-	Telus	-	Shaw	-	FortisBC	-
Underground Service		Underground Service		Underground Service			

Installed by:	Survey Date:	-
Comments:		

NOT TO SCALE The information contained herein is for internal use only.
Not to be relied on unless confirmed by site inspection and/or investigation.

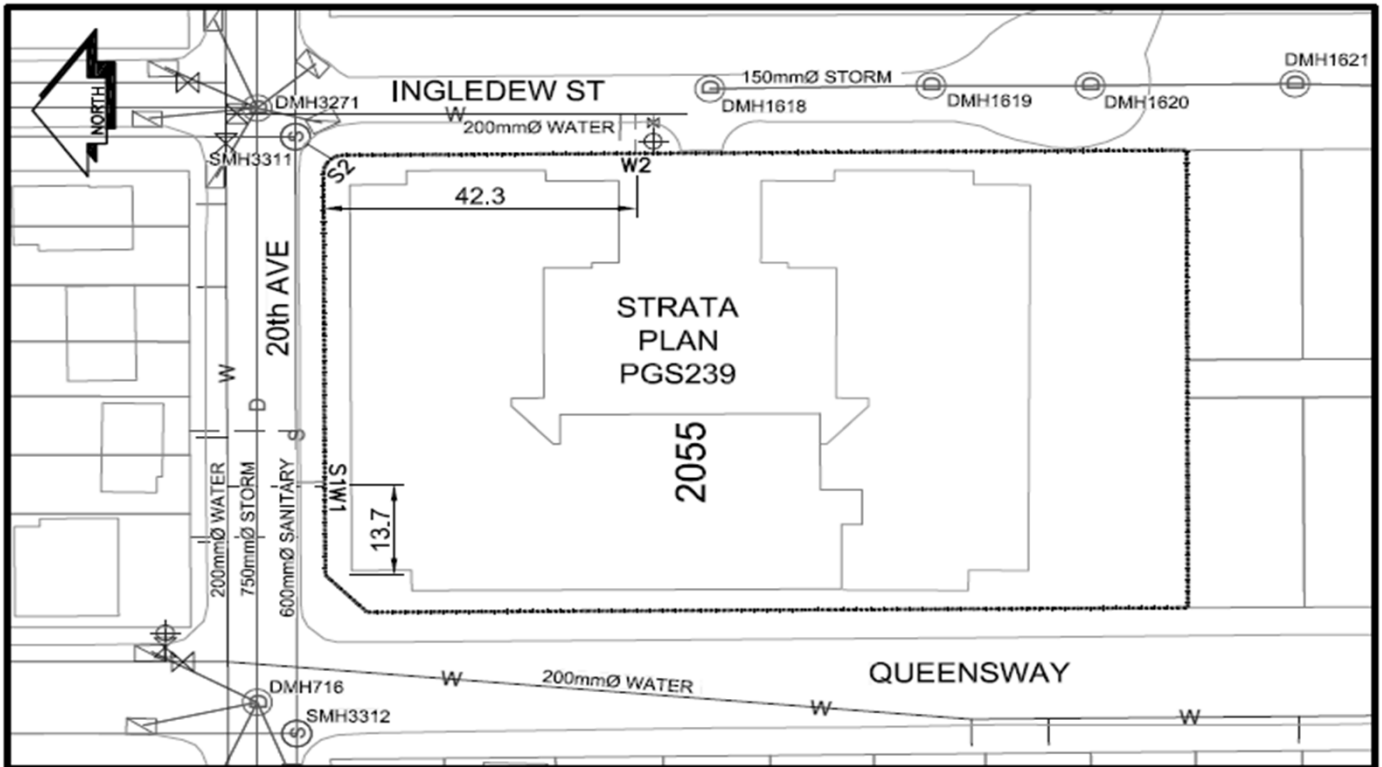

LEGEND:					
	CURB STOP		WATER SERVICE		STORM SERVICE
	CLEAN OUT		SANITARY SERVICE		GAS
	WATER VALVE		FIRE HYDRANT		ENCUMBRANCE

NOT TO SCALE