



City of Prince George History Sheet

PID:	PGS8
SD/MU:	
WO:	

Civic Address: 111 Tabor Blvd

Legal Description: Lot: CMLPX District Lot: 1427 Plan: PGS8


Service Type	Diameter (mm)	Material	Invert Elev at main (m)	Invert Elev at property line (m)	Invert Elev at service end (m)	Distance into property (m)	Installation Date
Sanitary	200mm	AC	-	-	-	-	January 1973
Water	200mm	AC	-	-	-	-	January 1974
Storm	250mm	CSP	-	-	-	-	January 1971

Service Connection Location	Sanitary (m)	Storm (m)
100mm Sanitary connected to SMH2455 (assumed)	-	
250mm Storm service connected to Stm MH 3335		

Power	Size	Communications	Size	Cable	Size	Gas	Size
BC Hydro	-	Telus	-	Shaw	-	FortisBC	-
Overhead Service		Overhead Service		Overhead Service			

Installed by:	Survey Date:	-
Comments: 200mm Water service assumed to service onsite fire hydrant and provide water service to site		

NOT TO SCALE The information contained herein is for internal use only.
Not to be relied on unless confirmed by site inspection and/or investigation.

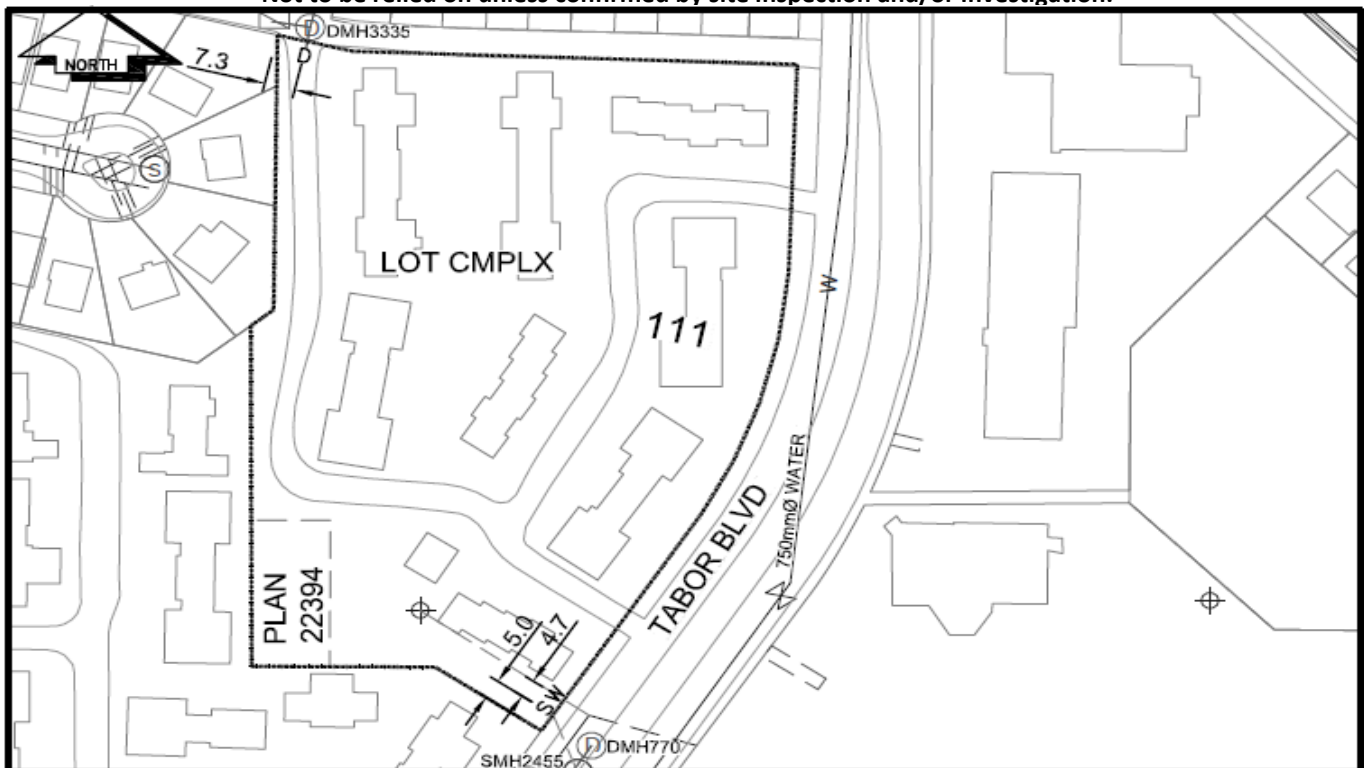

CS ^o CURB STOP	--- WATER SERVICE	--- STORM SERVICE
CO ^o CLEAN OUT	--- SANITARY SERVICE	--- GAS
⊗ WATER VALVE	⊗ FIRE HYDRANT	--- ENCUMBERANCE

NOT TO SCALE