


City of Prince George
HISTORY SHEET

DS

SHEET NUMBER		1633		Roll Number		PG53	
Legal:	LOT'S	B	BLOCK	D.L.	343	PLAN	21843
Address: 1654 10 th AVE.							
Sanitary Connection:	#	8980	SIZE	6"	MATERIAL	A.C.	INV. 82.31 CONNECTED YES
Water Connection	#	2221 8980	SIZE	1/2" 2"	MATERIAL	Cu	METER CONNECTED YES
Storm Connection:	#	468	SIZE	8"	MATERIAL	A.C.	INV. 83.06 CONNECTED YES
Cash Receipt No's:	WATER		SANITARY		528	STORM 530	
CURB FROM PROPERTY LINE		12'		PAVEMENT WIDTH		42'	
B.C. HYDRO	O.H.		UNDERGROUND CONNECTION				
B.C. TELEPHONE	O.H.		UNDERGROUND CONNECTION				
INLAND GAS	IN LANE & 2" MAIN						
Information Sheets:							
Comments:	BENCH MARK # 50-68 ELEVATION = 1893.76 S.I.P. S.E. CORNER 10 th AND PRINCE RUPERT LEVEL BOOK # 308-26						

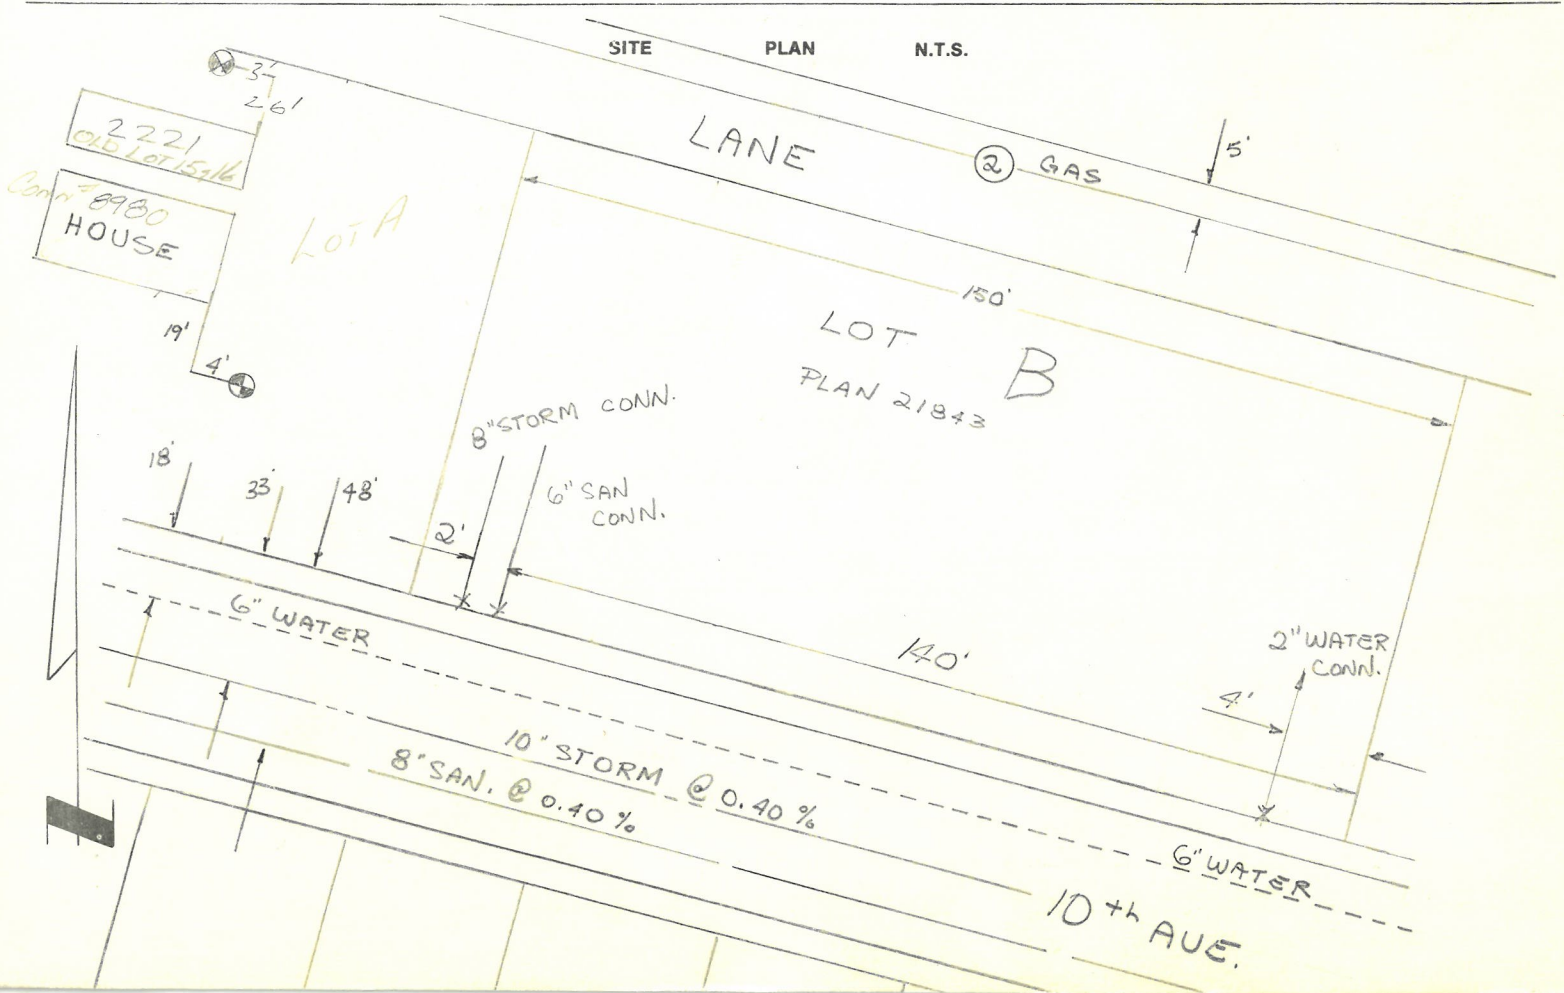

SANITARY & STORM INVERT CALCULATIONS

SANITARY

STORM

1. Distance from M.H. <u>46-5</u> to connection point is <u>298</u> ft. toward M.H.	<u>36-3</u>	<u>46-6-265' 46-5</u>
2. Calculated invert of main to conn. pt. is		<u>83.06</u>
3. Main Size at connection point is <u>8"</u> ins.		<u>10" .40</u>
4. Conn. invert at half diameter (Crown) of main is	<u>81.15</u>	<u>83.46</u>
5. Add to (4) allowance of 0.2 for 1/8 bend. Adjusted invert now	<u>81.35</u>	<u>83.66</u>
6. Dist. from main to P/L equals <u>48'</u> ft. at <u>1/4"</u> in/ft. gives rise of	<u>.96</u>	<u>33' @ 1/4" = 67</u>
7. Item (5) plus (6) equals Calculated Elev. of conn. inv. at P/L equals	<u>82.31</u>	<u>84.33</u>
13. Elev. of ref. hub top	<u>96.63</u>	<u>92.43</u>
14. Elev. of invert at P/line	<u>82.31</u>	<u>84.33</u>
15. Difference or cut below at property line	<u>3.14m</u>	<u>2.47m</u>
16. Survey Date <u>JUNE 24-25</u> 19 <u>74</u> Book Ref. <u>L308-26</u> by	<u>2.743m</u>	<u>2.47m</u>
17. Cut at P/Line in feet and inches		

Sanitary History:

Water History: THAW WIRE - YES

CONN. 8980

THERE WERE 3 OLD SERVICES WHICH WERE CUT OFF AT MAIN
AUG 1/74 - TURN ON REQ'D BY: HOCK MECH.

CONN. 2271 THAW WIRE: NO 1955-56 FROZEN
LOCATED MAY 22/66

Storm History: