City of Prince George
HISTORY SHEET

667

SHEET NUMBER **Roll Number**

Legal: LOT'S 1-2 BLOCK D.L. 936 PLAN 15557

Address: 1445 WEST CENTRAL STREET

Sanitary Connection: # 5359 / 8865 SIZE 100mm / 200mm MATERIAL ACS INV. CONNECTED

Water Connection # 4353 / 8865 SIZE 25mm / 150mm MATERIAL CAST METER CONNECTED

Storm Connection: # 405 SIZE 300mm MATERIAL INV. CONNECTED

Cash Receipt No's: WATER 188 SANITARY 187 STORM 189

CURB FROM PROPERTY LINE PAVEMENT WIDTH

B.C. HYDRO UNDERGROUND CONNECTION

B.C. TELEPHONE UNDERGROUND CONNECTION

INLAND GAS

Information Sheets:

Comments:
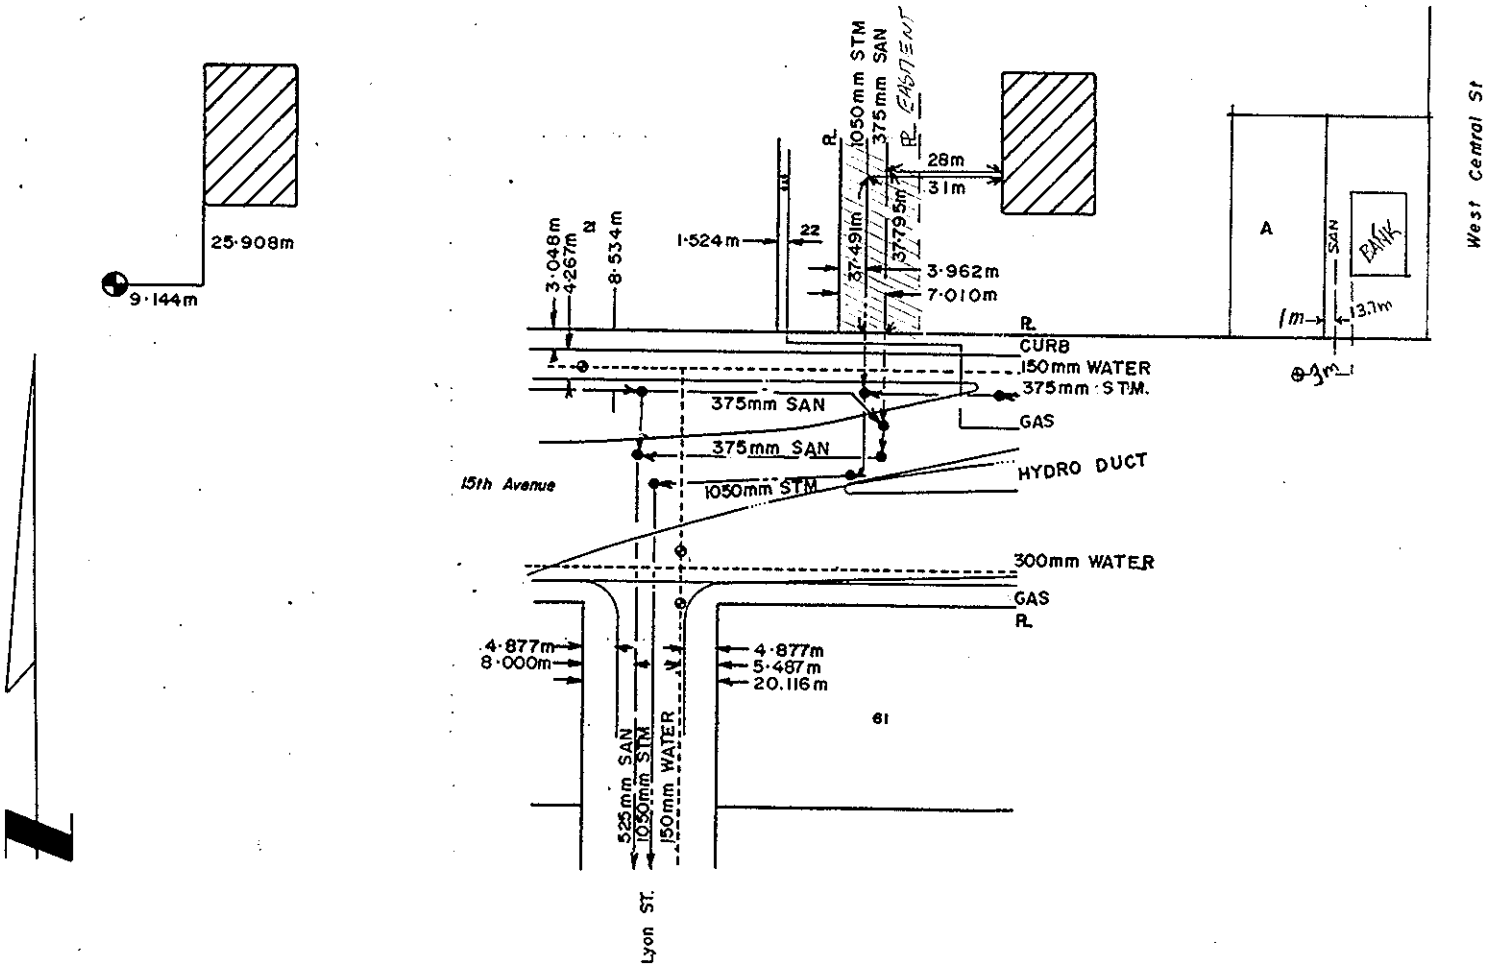
THE INFORMATION CONTAINED HEREIN IS FOR INTERNAL USE ONLY.
NOT TO BE RELIED UPON UNLESS CONFIRMED BY SITE INSPECTION AND/OR INVESTIGATION