City of Prince George

HISTORY SHEET

PID: 027141101 Scale: 1:500

Legal: LOT 6 D.L.: 905 PLAN: BCP31387

Address: ~~XXXXXXXXX~~ 2805 Gangi Crt

Sanitary Connection:#	SIZE: 100mmØ	MATERIAL: PVC	INV. 642.01m	CONNECTED
Water Connection:#	SIZE: 19mmØ	MATERIAL: COPPER	INV. 641.93m	METER
Storm Connection:#	SIZE 100mmØ	MATERIAL PVC	INV. 642.00m	CONNECTED

Cash Receipt No's: WATER SANITARY STORM

CURB FROM PROPERTY LINE 5.0m PAVEMENT WIDTH 10.0m

B.C. HYDRO	75mm DB2	U/G CONNECTION	✓
B.C. TELEPHONE	50mm DB2	U/G CONNECTION	✓
B.C. GAS	42 PROP/P.E.		

Information Sheets: REFERENCE DRAWINGS L&MENGINEERING LIMITED JOB NO. 1292-01-04

Comments:

CS ● CURB STOP
CO ● CLEAN OUT
SDW WATER SERVICE
STORM SERVICE
SANITARY SERVICE
HC HYDRO SERVICE
CABLE SERVICE
TELECOMMUNICASTIONS
GAS GAS
E ELECTRICAL
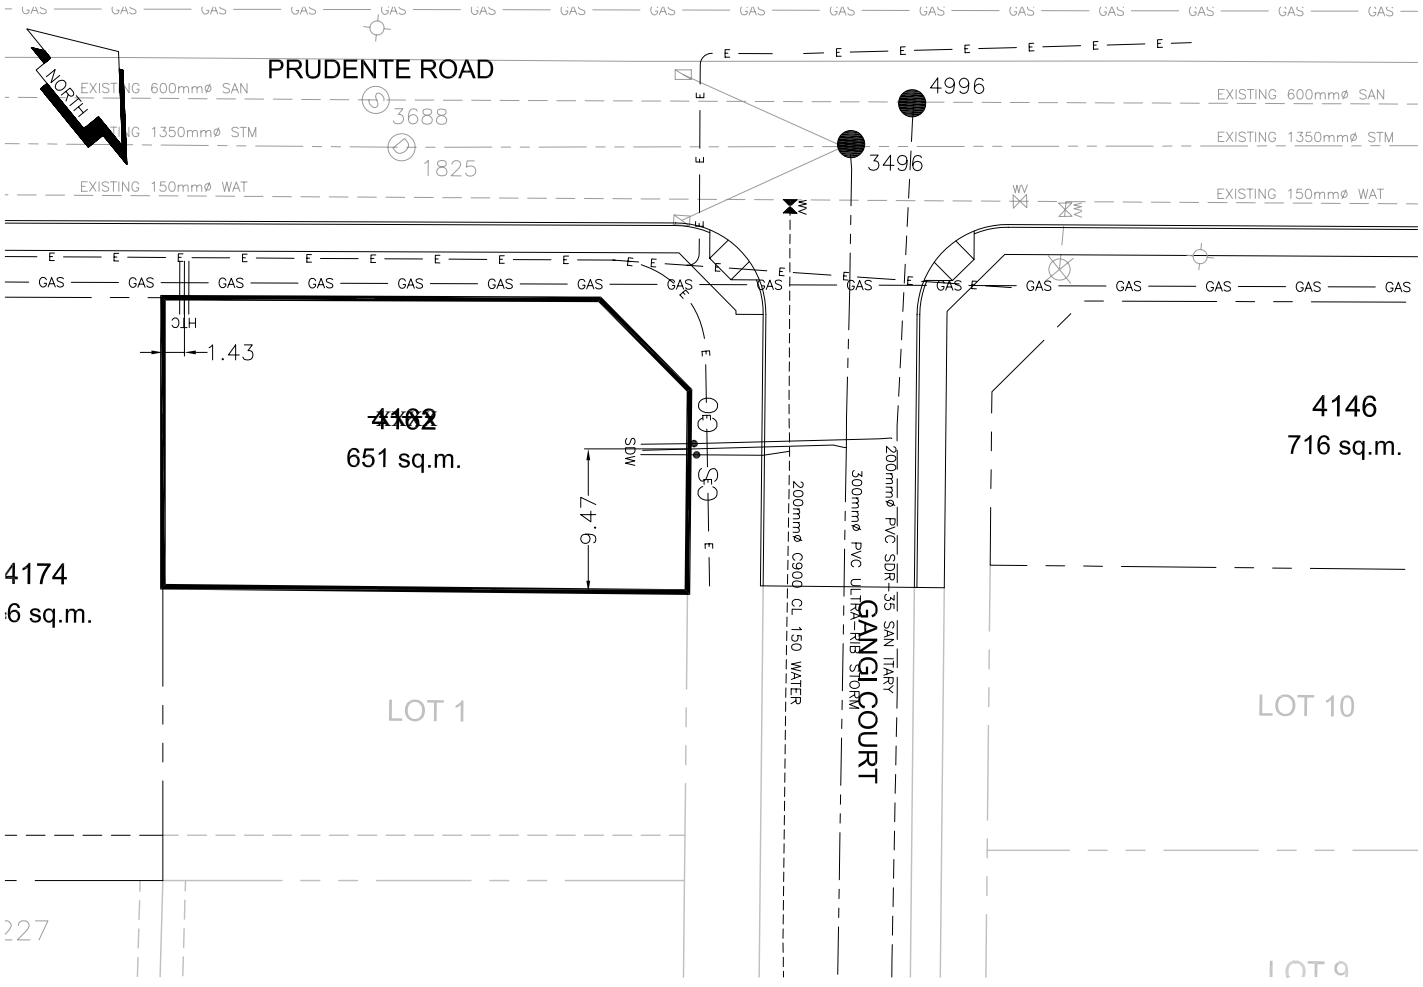
THE INFORMATION CONTAINED HEREIN IS FOR INTERNAL USE ONLY.
NOT TO BE RELIED UPON UNLESS CONFIRMED BY THE SITE INSPECTION AND/OR INVESTIGATION