Stanley Associates Engineering Ltd.
412, 1438 - 4th Avenue
Prince George, B.C.
V2L 4Y2

City of Prince George
HISTORY SHEET

SHEET NUMBER 3886 Roll Number 00269 7701

Legal: LOT'S 15 BLOCK D.L. 2103 PLAN 025644

Address: 7740 ST. DENIS PL

Sanitary Connection: # SIZE 100 ϕ MATERIAL P.V.C. INV. 645.122 CONNECTED

Water Connection # SIZE 20 ϕ MATERIAL Copper METER CONNECTED

Storm Connection: # SIZE 100 ϕ MATERIAL P.V.C INV. 645.137 CONNECTED

Cash Receipt No's: WATER SANITARY STORM

CURB FROM PROPERTY LINE PAVEMENT WIDTH 10.000

B.C. HYDRO UNDERGROUND CONNECTION U/G - MID LOT

B.C. TELEPHONE UNDERGROUND CONNECTION U/G - MID LOT

INLAND GAS

Information Sheets:

Comments: INLAND GAS PROPOSED ONLY

BENCH MARK - HYD# HD34A N.W. COR. ST. MARKS CRES. & ST. MATTHEW PL.
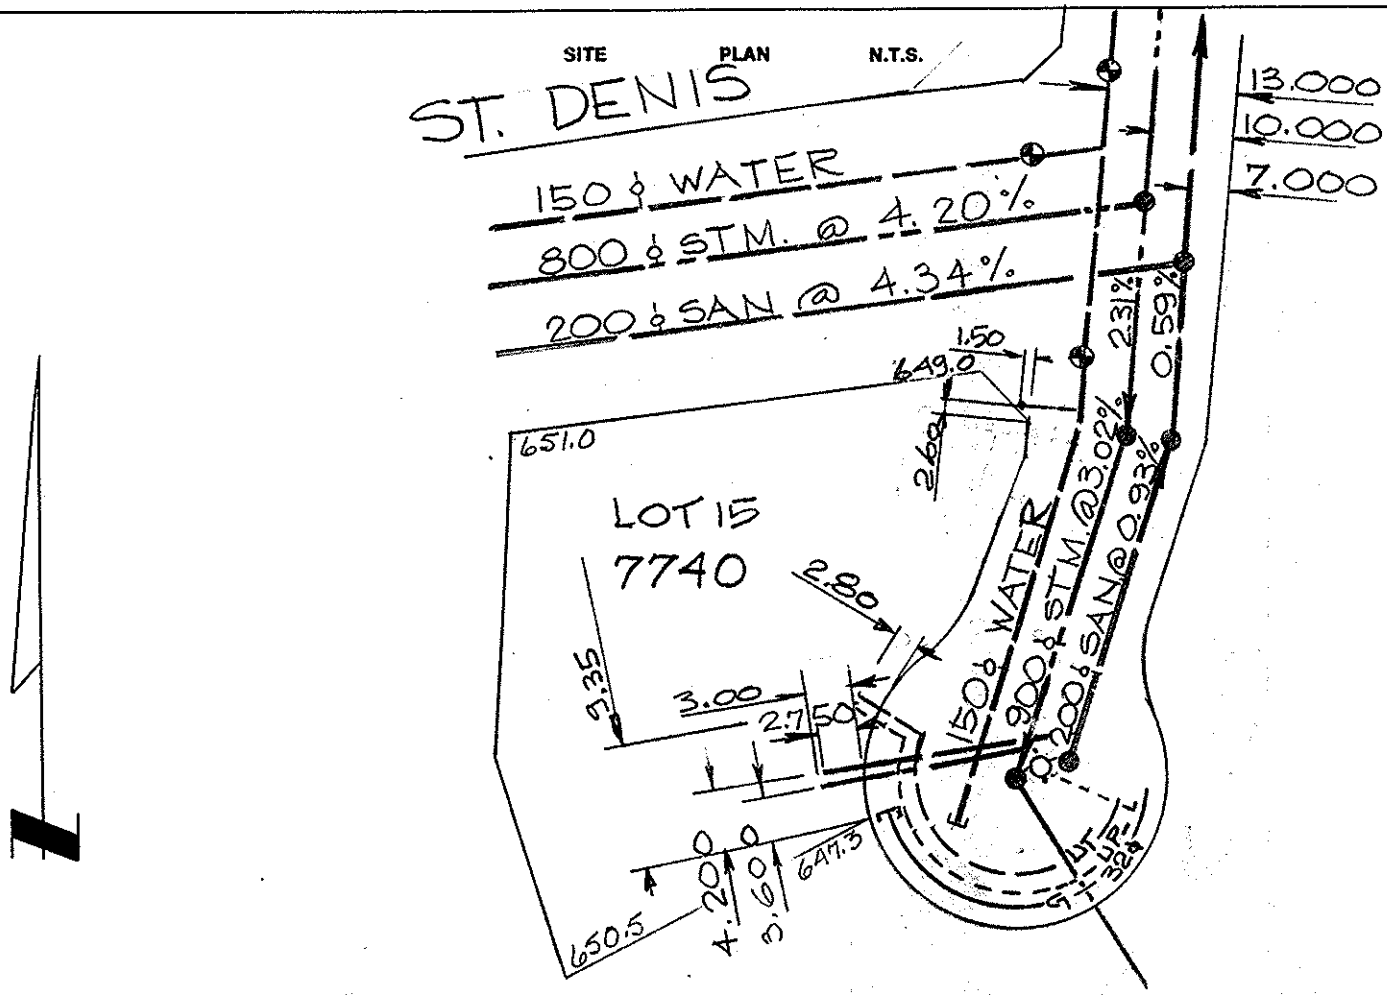
SITE PLAN N.T.S.